


SECTION 8, T.16S., R.12E., W.M.
DESCHUTES COUNTY, OREGON

RECEIVED

OCT - 3 1994


WATER RESOURCES DEPT.
SALEM, OREGON

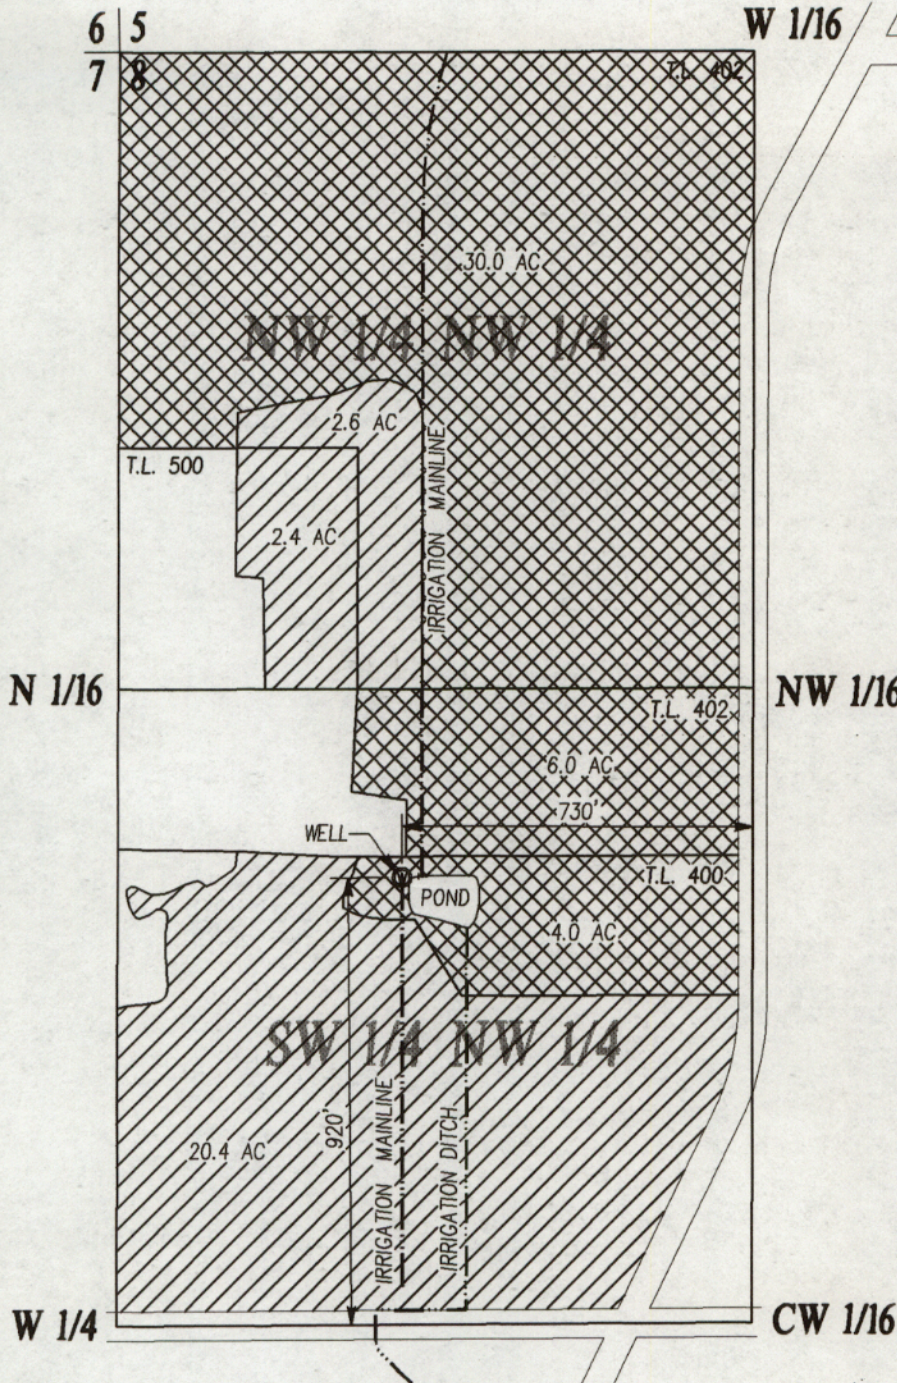

NORTH

SCALE: 1" = 400'


PERMIT No. G-11016
GROUND WATER SUPPLEMENT

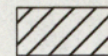

CERT. #S 31410, 26508,
& 26050.



INCHOA TE PERMIT #27840

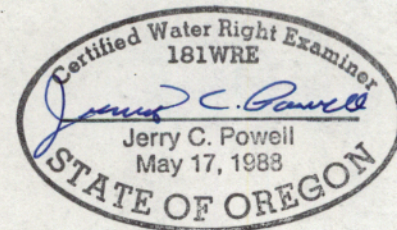

THIS MAP IS FOR THE PURPOSE OF LOCATION A
WATER RIGHT AND IS NOT INTENDED TO PROVIDE
LEGAL DIMENSIONS FOR PROPERTY BOUNDARIES.



DAVID EVANS AND ASSOCIATES, INC
709 NW WALL STREET, SUITE 102
BEND, OREGON 97701 (503)389-7614

FINAL PROOF SURVEY
FOR
TIM DAVIS

scale 1" = 400' design
date 9/28/94 drawn JHL
file WREX0008 - WREX08.DWG