



T.5S. R.2E. Section 4, W.M.

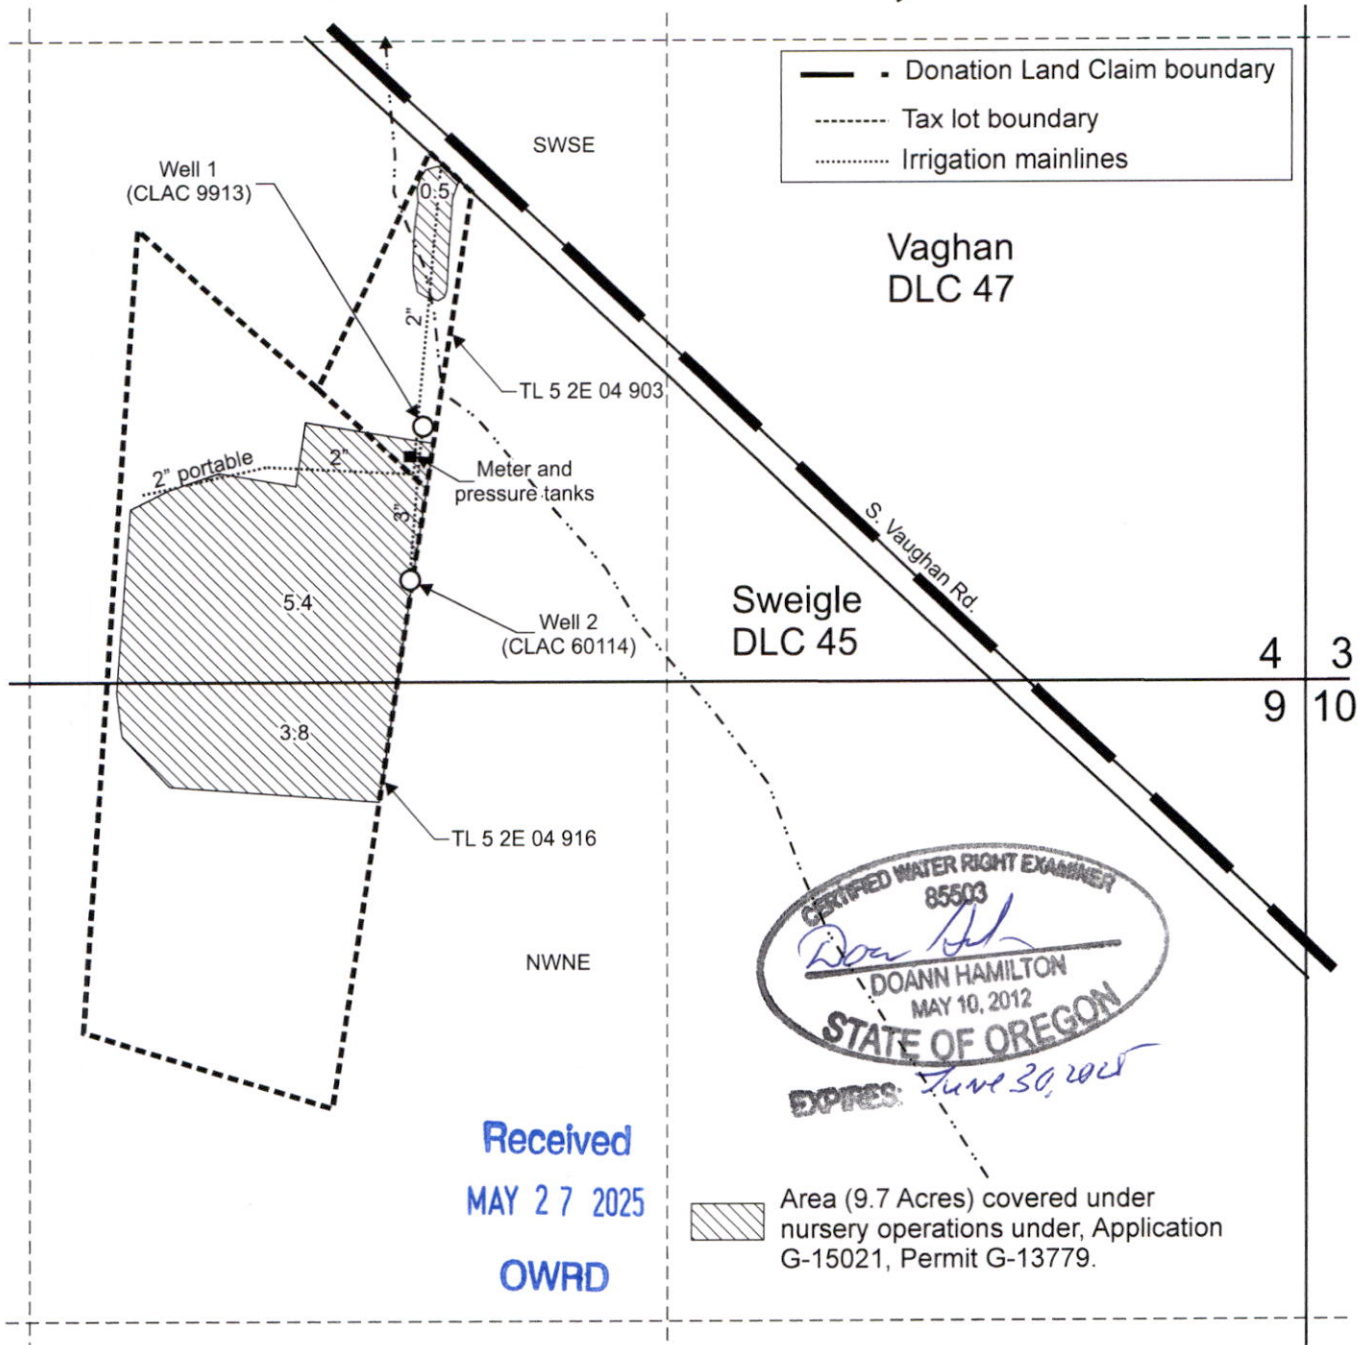

Well 1 (CLAC 9913) is located 525 feet north and 1,830 feet west from the SE corner, Section 4.
Well 2 (CLAC 60114) is located 210 feet north and 1,855 feet west from the SE corner, Section 4.

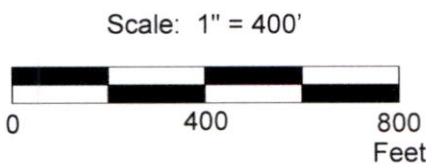

This map was prepared for the purpose of identifying the location of a water right only and is not intended to provide legal dimensions or location of property ownership lines.

Claim of Beneficial Use Map
Application G-15021, Permit G-13779

Bradley and Sabreena Lepley
T.5S. R.2E. Section 4, W.M.

04/2025

Pacific Hydro-Geology Inc.