


Claim of Beneficial Use
C & E Brentano Family LP / RD Farms Inc.
Transfer T-12917

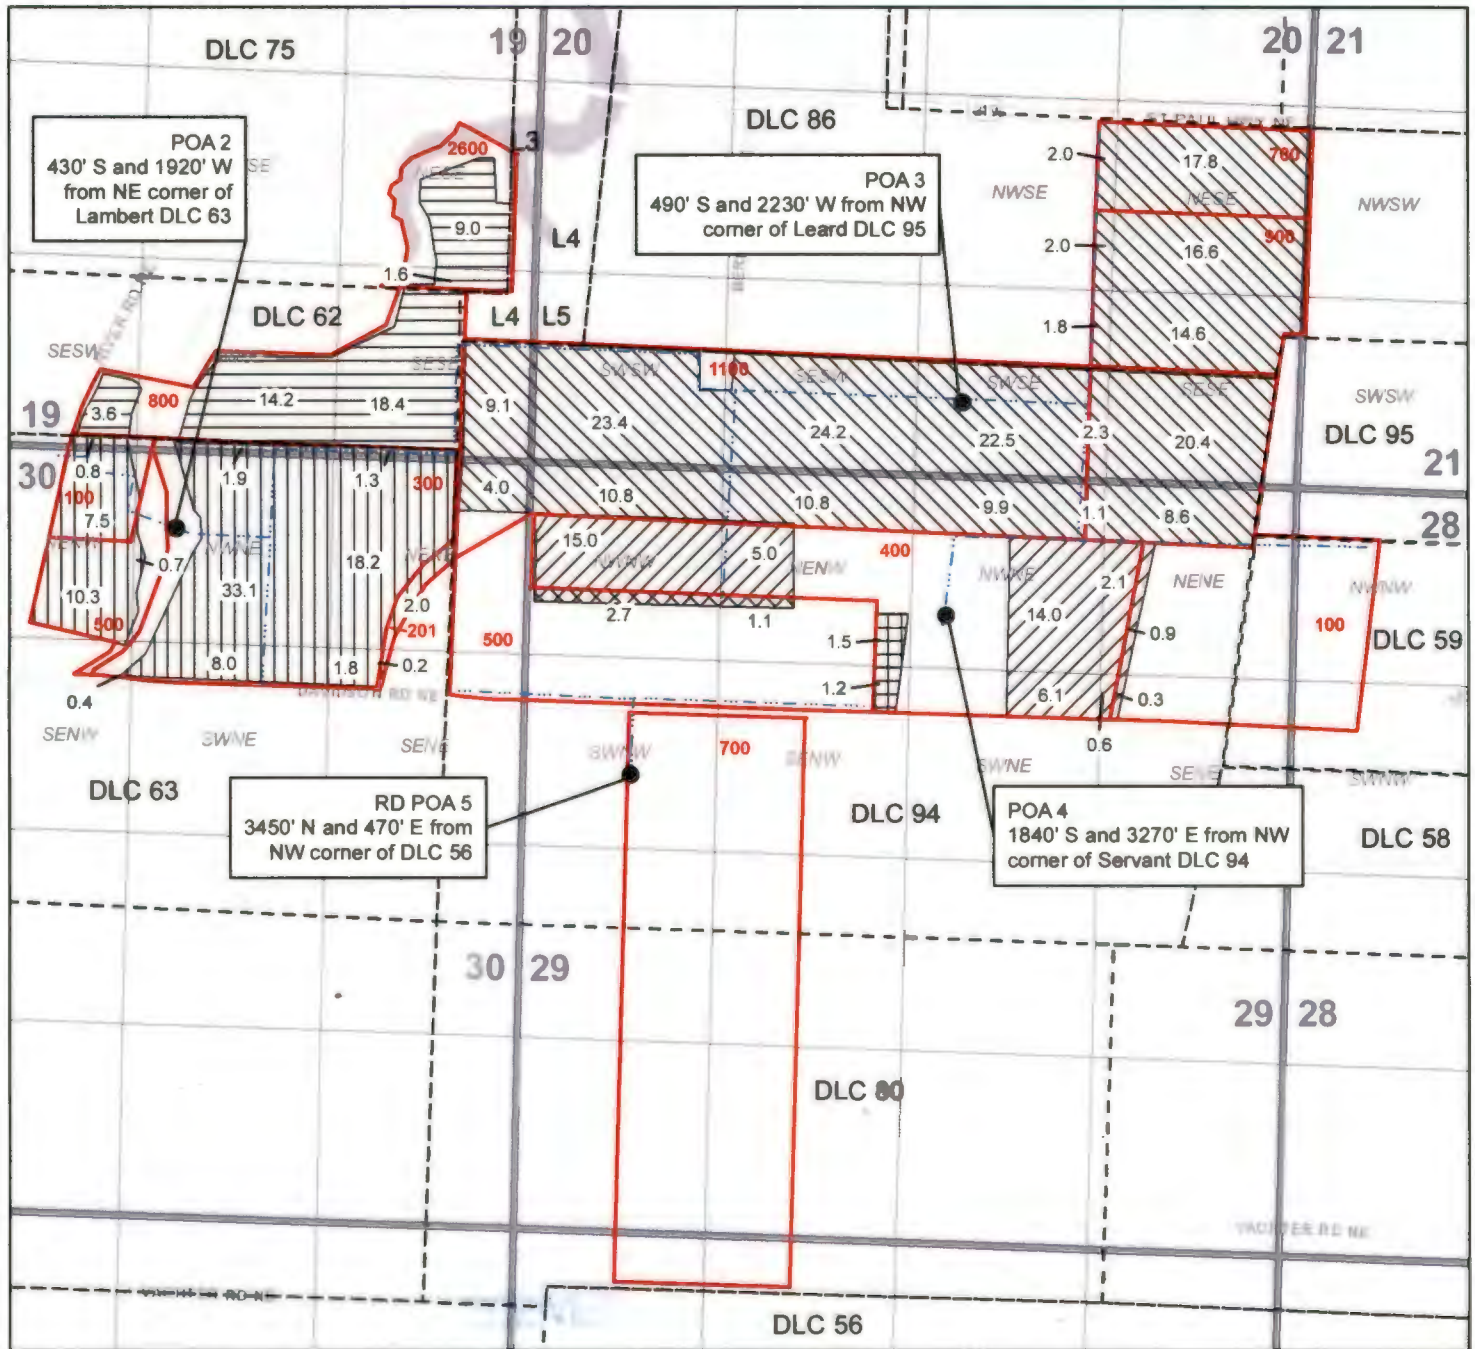

Township 4S, Range 2W, W.M.



0 660 1,320 2,640 Feet

This map is not intended to provide legal dimensions or locations of property ownership lines.

Legend

- | | | | |
|--|----------------------------------|--|-------------------------------------|
| | T-12917 POU (94734 CN, POA 3, 4) | | T-12917 POU (35370 CN, POA 2, 3, 4) |
| | T-12917 POU (40094 CN, RD POA 5) | | Mainline |
| | T-12917 POU (40094 CN, POA 3, 4) | | DLC |
| | T-12917 POU (35497 CN, POA 3, 4) | | Taxlots |
| | T-12917 POU (35496 CN, POA 3, 4) | | |



EXPIRES: 12-31-2024