


**Map of Claim of Beneficial Use
Application R-86875
Permit R-14463**

T 39 S, R19 E, Sec. 19, W.M.
Louis Brown

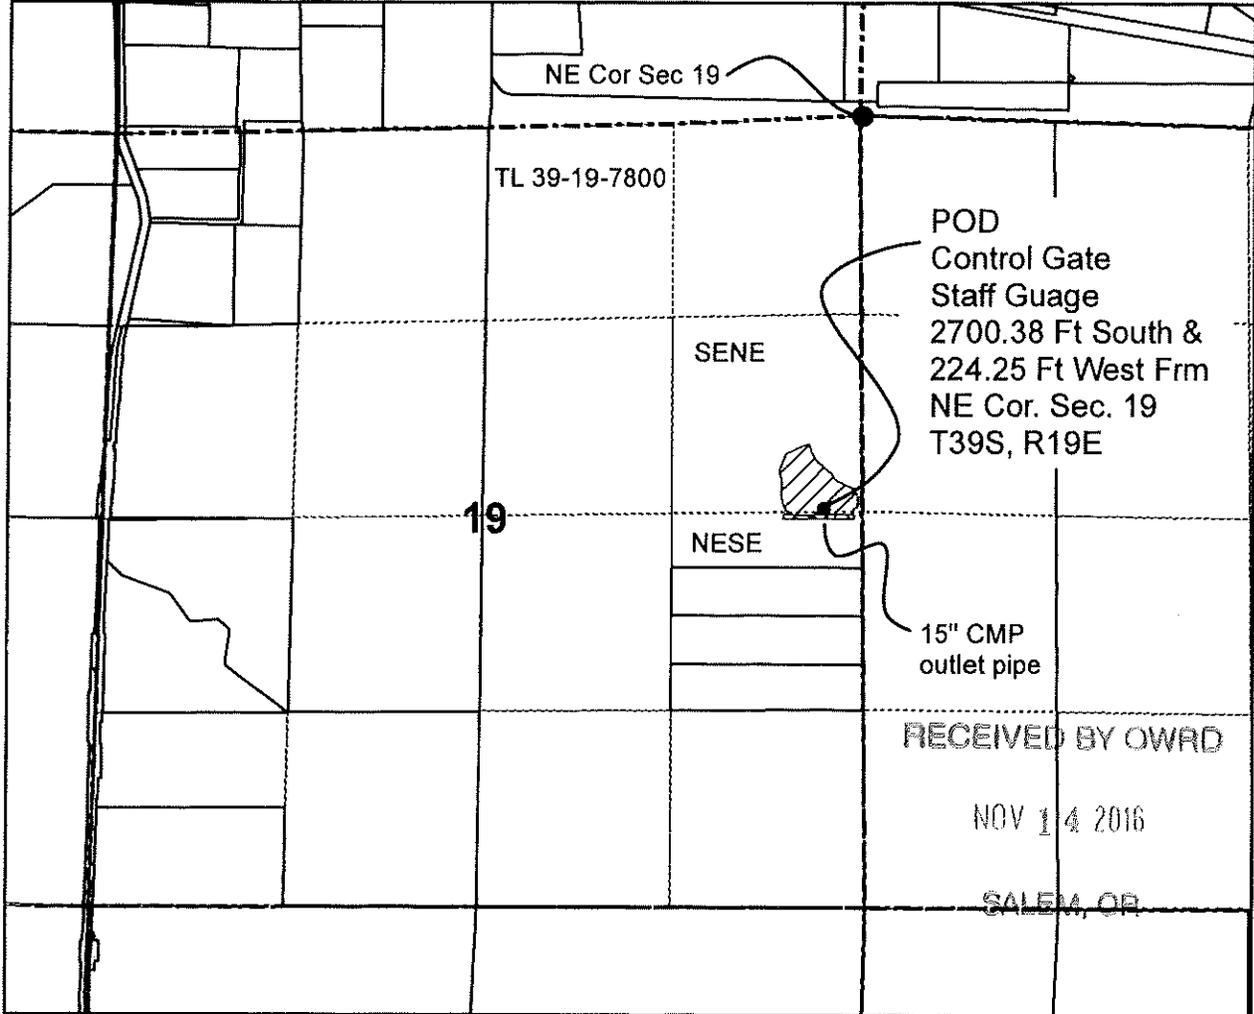

Legend

- POD
-  Area covered by reservoir
-  Section line
-  Quarter-Quarter line



1 inch = 1,320 feet

Note: This map is not intended to provide legal dimensions or locations of property ownership lines.

