

CLAIM OF BENEFICIAL USE MAP

APPLICATION: S-87157, PERMIT: S-54486

PRIORITY DATE: 4/24/2008

QUASI-MUNICIPAL USE

FOR

CROWFOOT ROAD WATER IMPROVEMENT DISTRICT

560 GROVE STREET

JACKSONVILLE, OR 97530


SITUATED IN

SECTION 32, TOWNSHIP 33 SOUTH, RANGE 1 EAST, W.M.


JACKSON COUNTY, OREGON



RENEWES: 12/31/2024

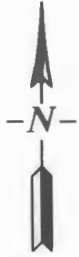

0 660 1320
SCALE: 1"=1320'

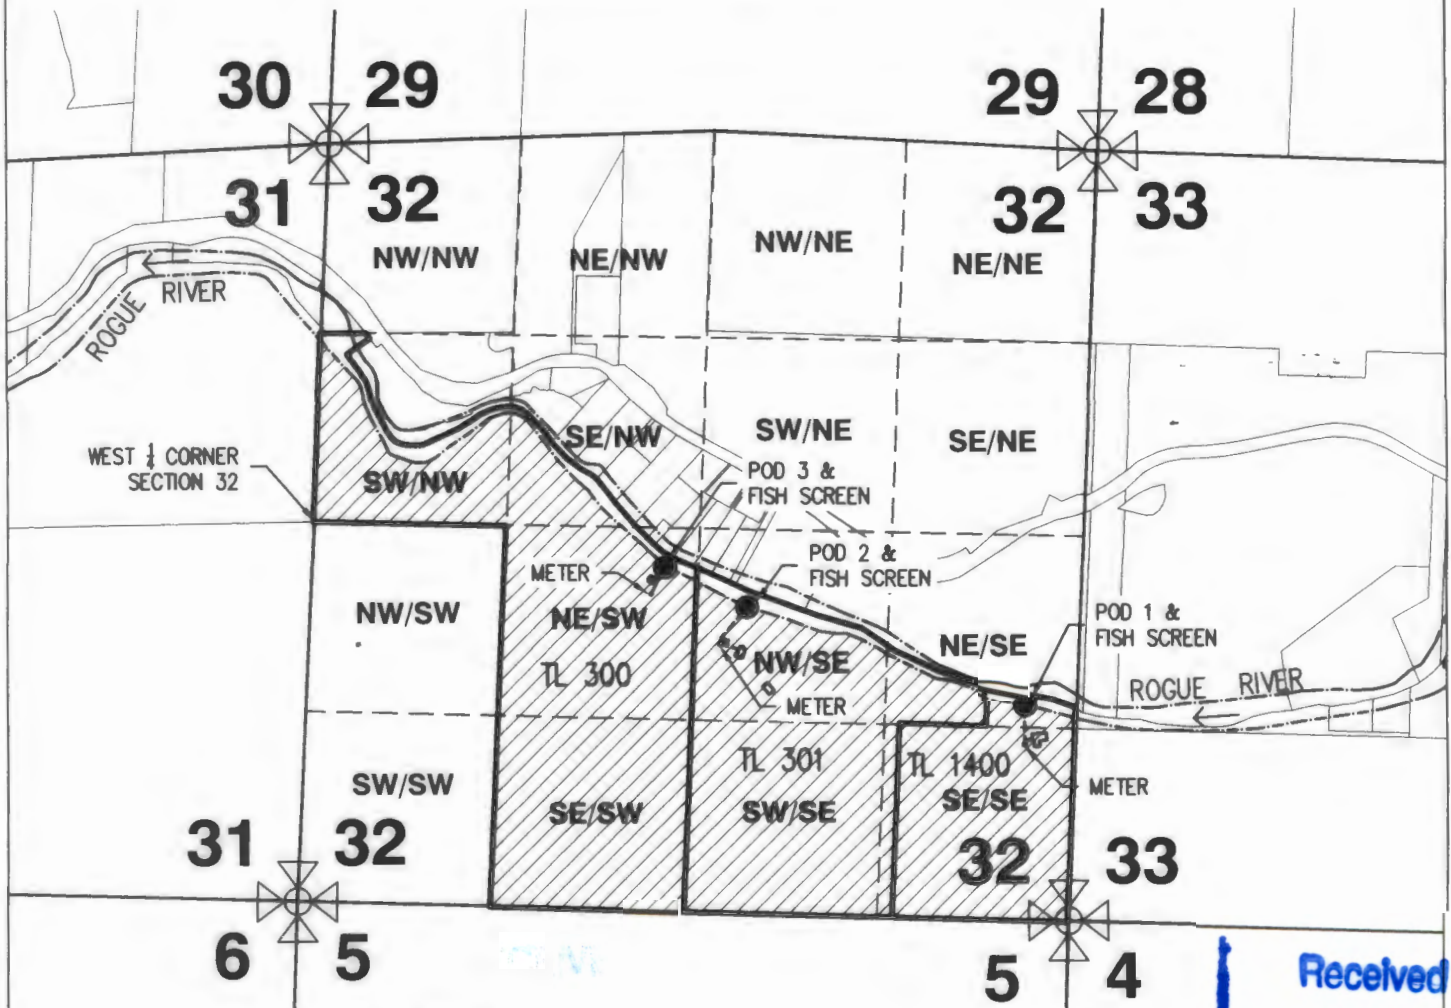

LEGEND

- POD 1
1275' SOUTH AND 4882' EAST
OF W $\frac{1}{4}$ CORNER SECTION 32.
- POD 2
605' SOUTH AND 2973' EAST
OF W $\frac{1}{4}$ CORNER SECTION 32.
- POD 3
328' SOUTH AND 2433' EAST
OF W $\frac{1}{4}$ CORNER SECTION 32.

PLACE OF USE
QUASI-MUNICIPAL

--- 1/4-1/4
SECTION LINE

----- WATERLINE
(APPROXIMATE)

----- EDGE OF ROGUE RIVER
(APPROXIMATE)

This map is not intended to
provide legal dimensions or
locations of property
ownership lines.

EHM-July 9, 2024
ROGUE CIVIL LLC
emalepsy@roguecivil.com 541-621-2868

Received
DEC 19 2024
OWRD