


Claim of Beneficial Use - Jubitz

Application S-87918, Permit S-54848

Township 3S, Range 1E, Sec. 19, W.M.

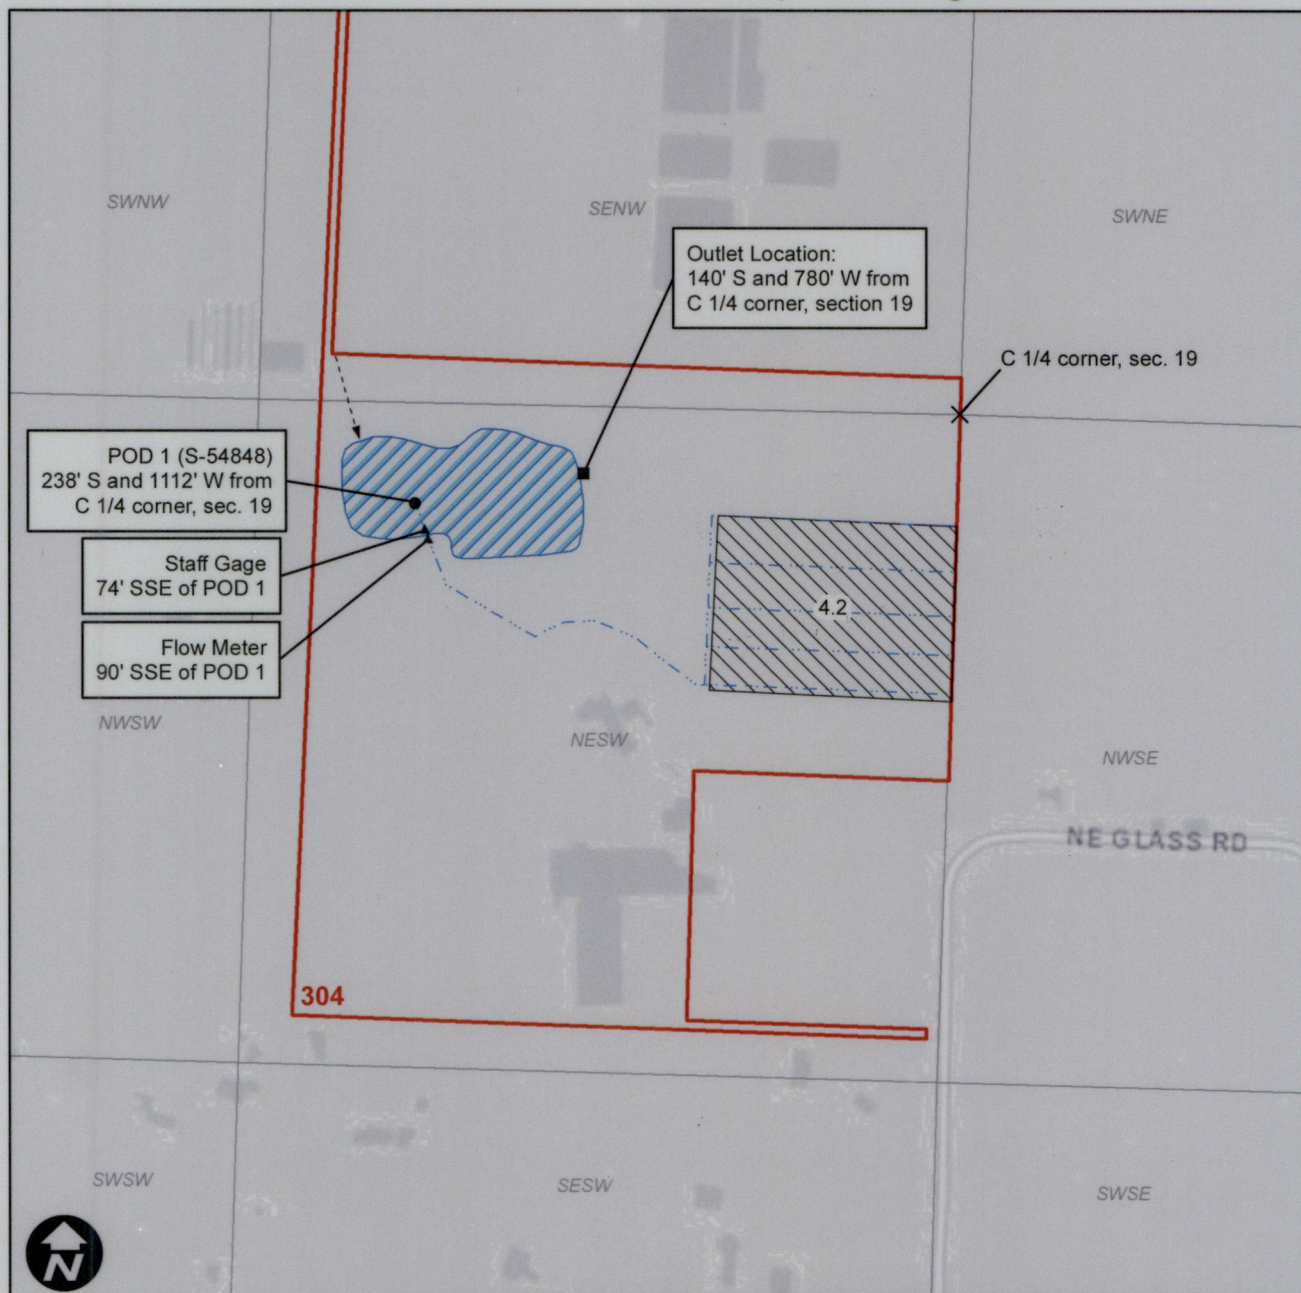

0 200 400 800 Feet

This map is not intended to provide legal dimensions or locations of property ownership lines.

Legend



IR POU



IR Mainline



French Hill Reservoir

-----> Inlet Pipe



Taxlot



Received

DEC 23 2024

OWRD

EXPIRES: 12-31-2026