


T.4S. R.2W. Section 30, and T.4S. R.3W. Section 25, W.M.

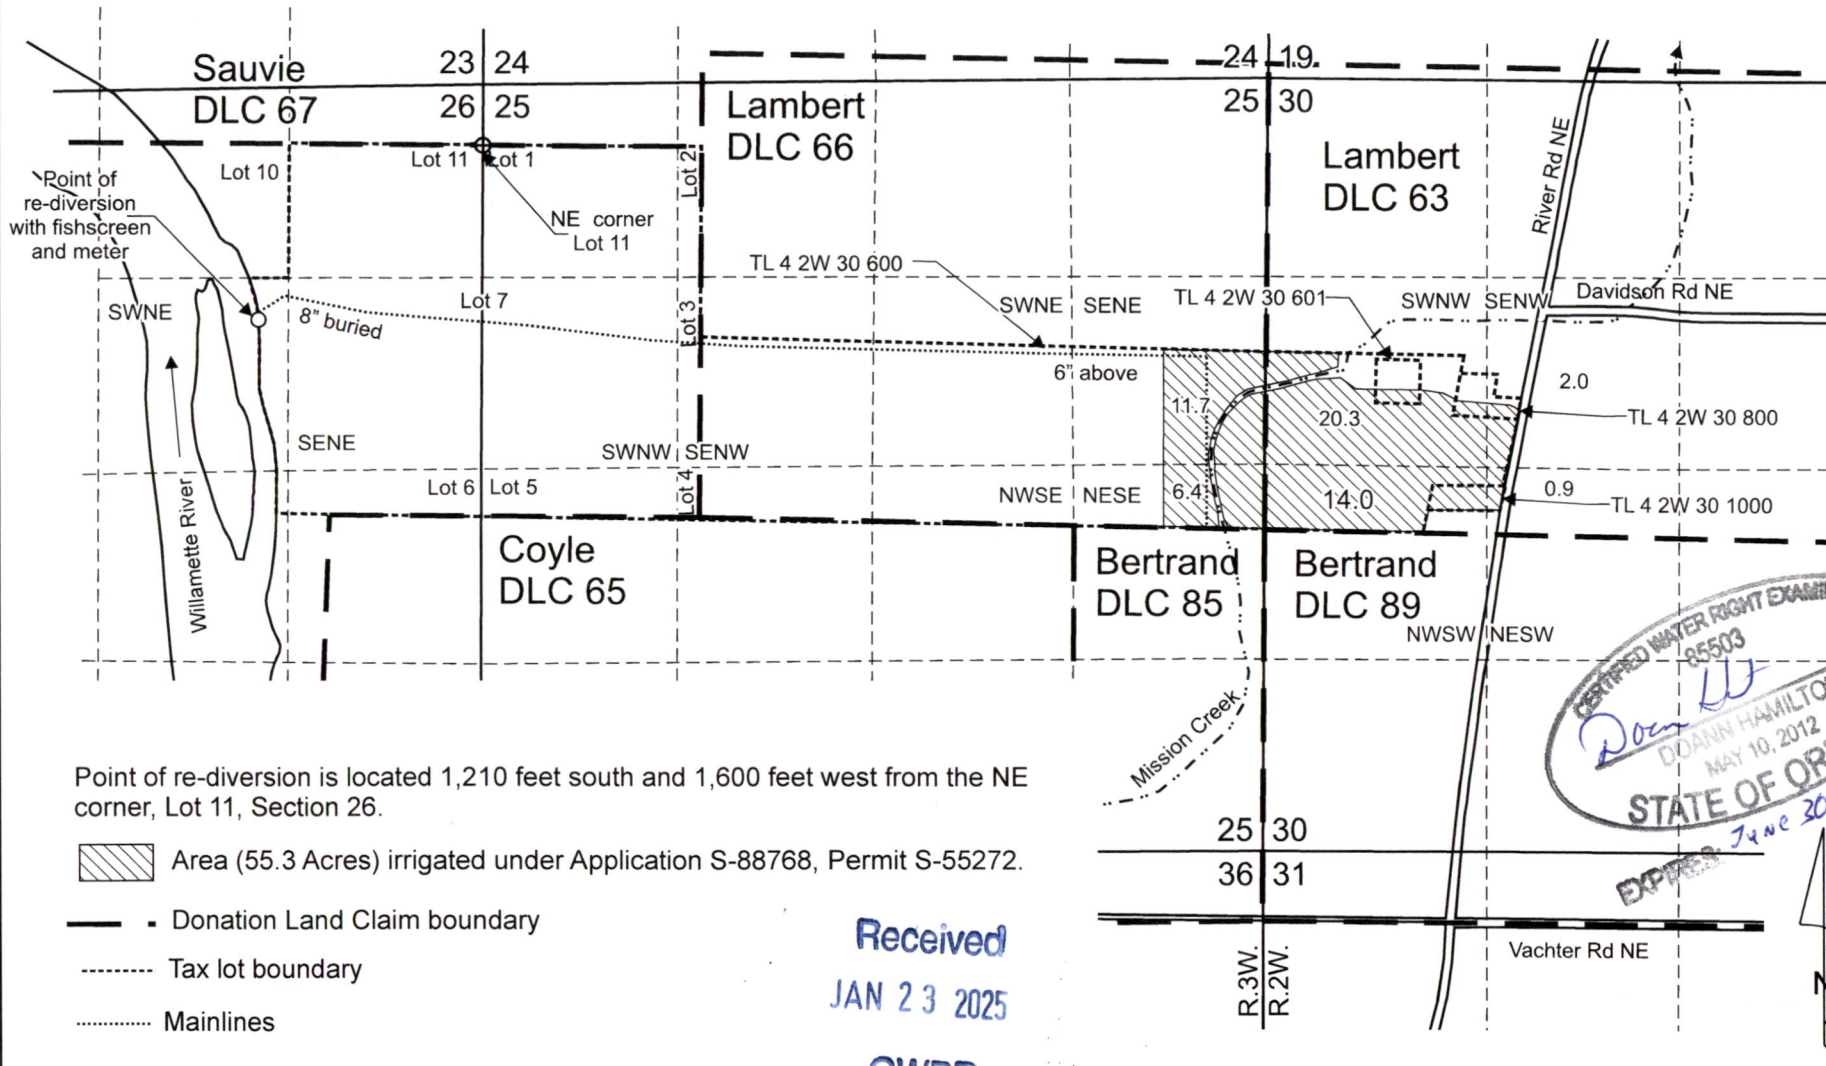

CERTIFIED WATER RIGHT EXAMINER
 85503
 DOANN HAMILTON
 MAY 10, 2012
 STATE OF OREGON
 EXPIRES June 30, 2025