


RECEIVED

JUL 18 2019


OWRD



SCALE: 1"=1320

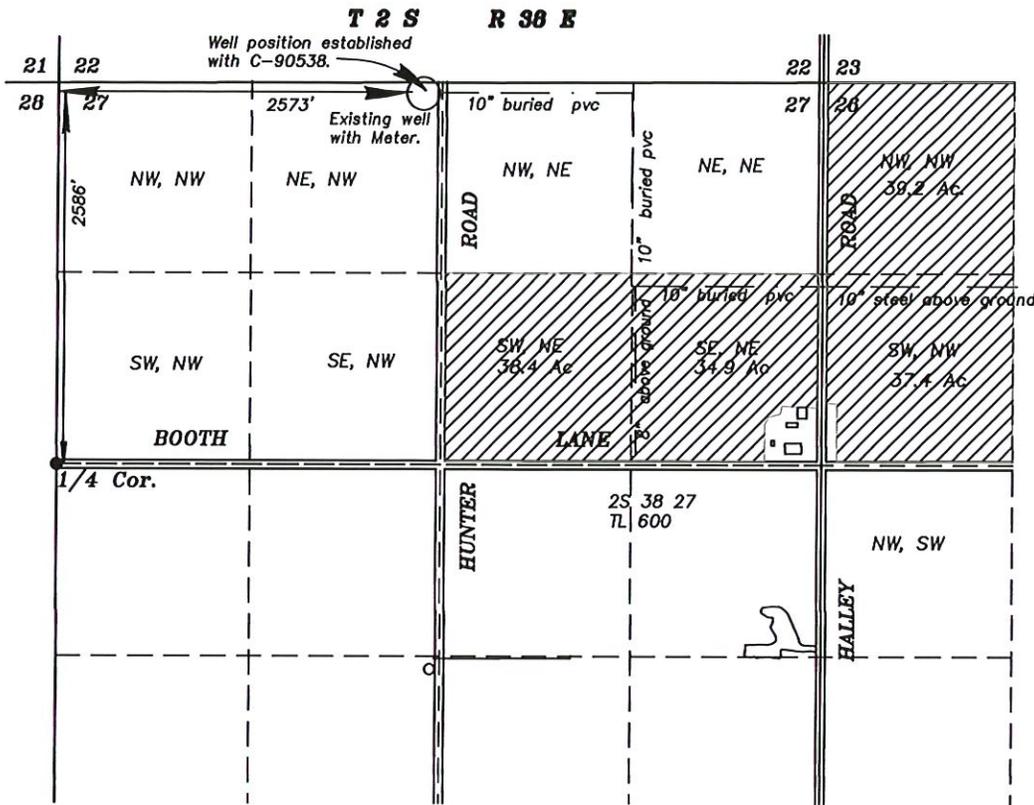

Lands irrigated under G-15922

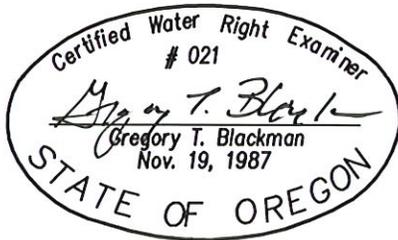

CLAIM OF BENEFICIAL USE MAP  
AUTHORIZED UNDER G-15922  
FOR  
MT. HARRIS FARMS

BY  
GREG BLACKMAN WATER RIGHTS  
126 RIDGE DRIVE  
LA GRANDE, OREGON 97850  
October 25, 2018

APPLICATION NO. G-16351

PERMIT NUMBER G-15922

NOTE: The preparation of this map was for the purpose of identifying the location of the proposed water right and has no intent to provide dimensions or location of property ownership lines. Location information shown hereon was furnished by the applicant.