

**T16S R4W, WM
LANE COUNTY, OR**



0 400
Feet

1" = 400'

● Well & Meter

----- Pipeline

- - - - - DLC

□ Section

----- Quarter Quarter


□ Tax Lot

▨ POU IR

Well (LANE 8066) Location:
80' N, 1120' W of SW Cor DLC 48



RENEWAL DATE 12/31/2025

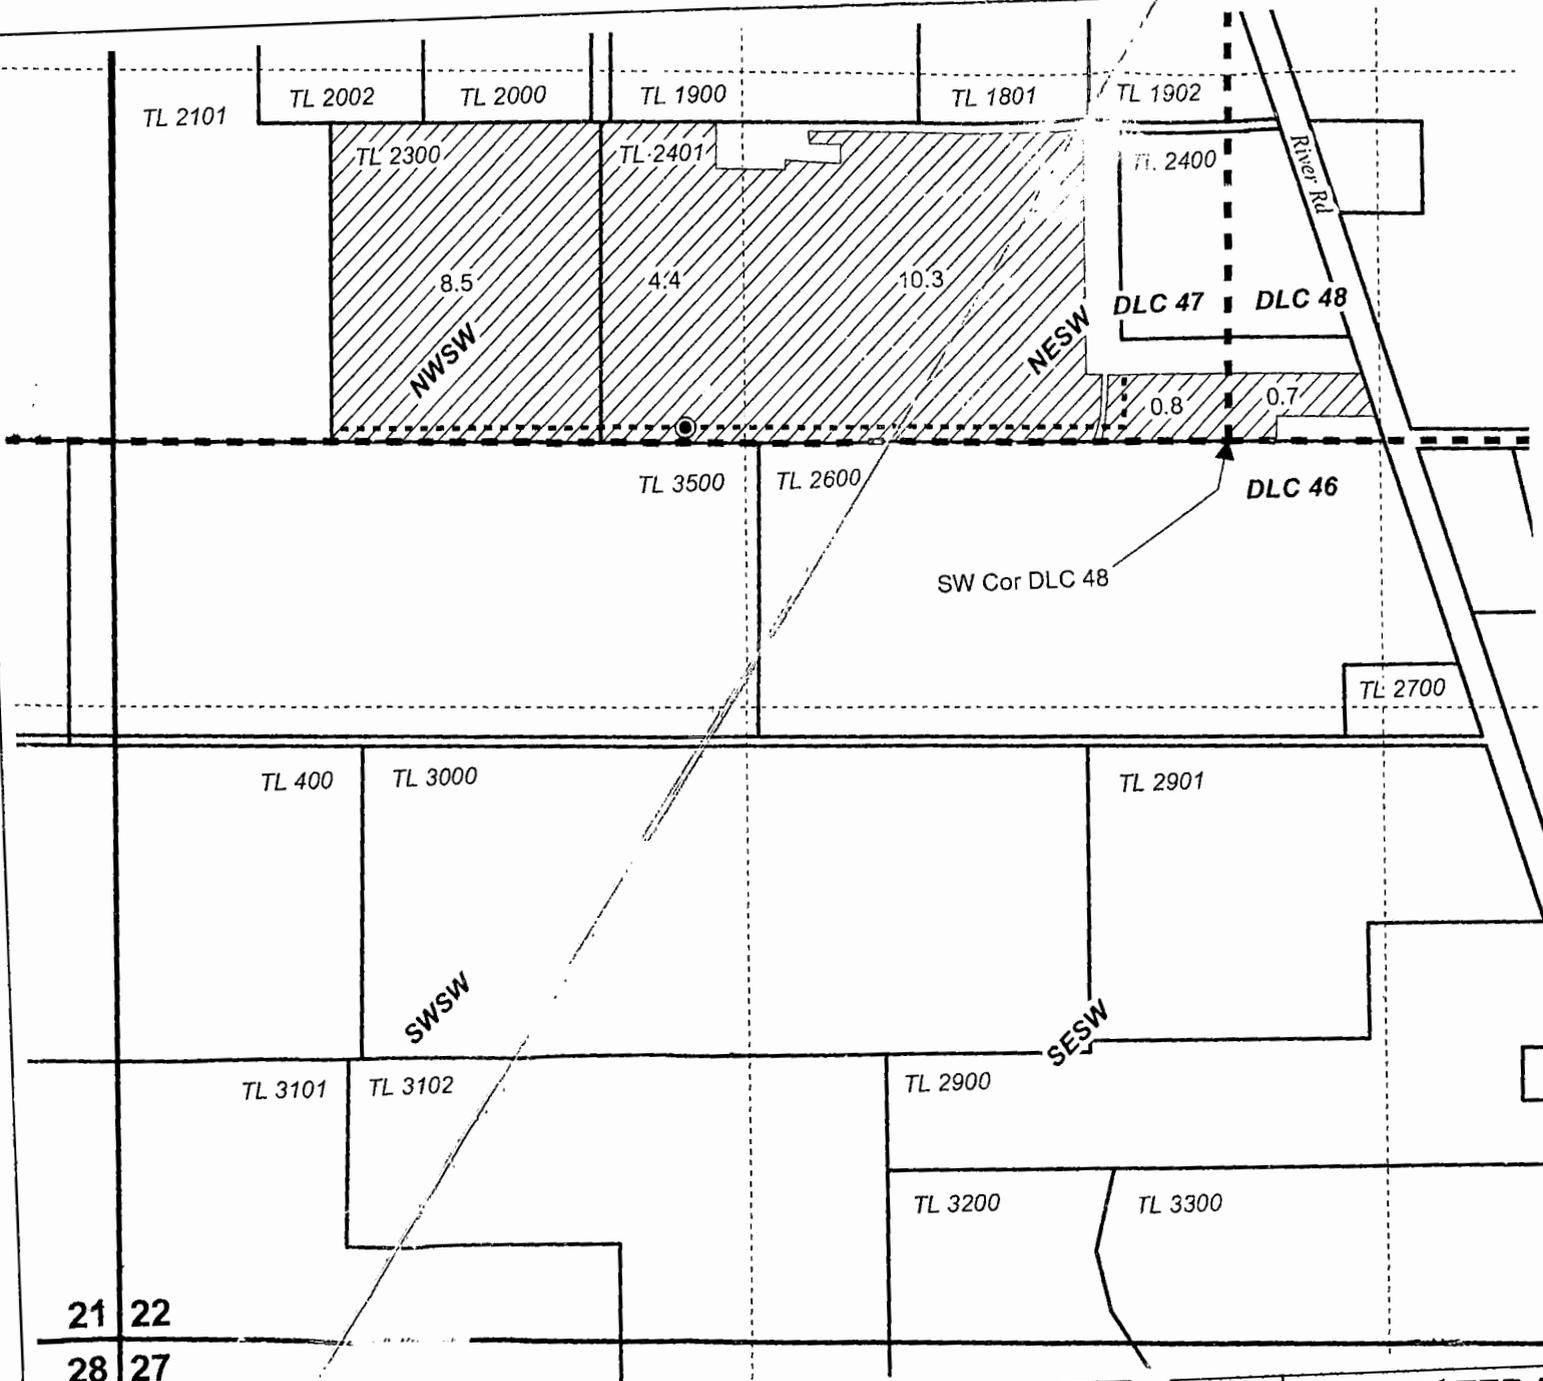

21 22

28 27

**CLAIM OF BENEFICIAL USE MAP
RUSSELL**

This map is not intended to provide legal dimensions or locations of property ownership lines.

WATER RIGHT SERVICES, LLC
PO BOX 1830, BEND, OR 97709
WWW.OREGONWATER.RIS CCB # 197121
johnshort@usa.com 541-389-2837

Date: 7/5/2024

Ap G-17453 Permit G-16892 #24013