


T. 3 S. R. 39 E., W. M.

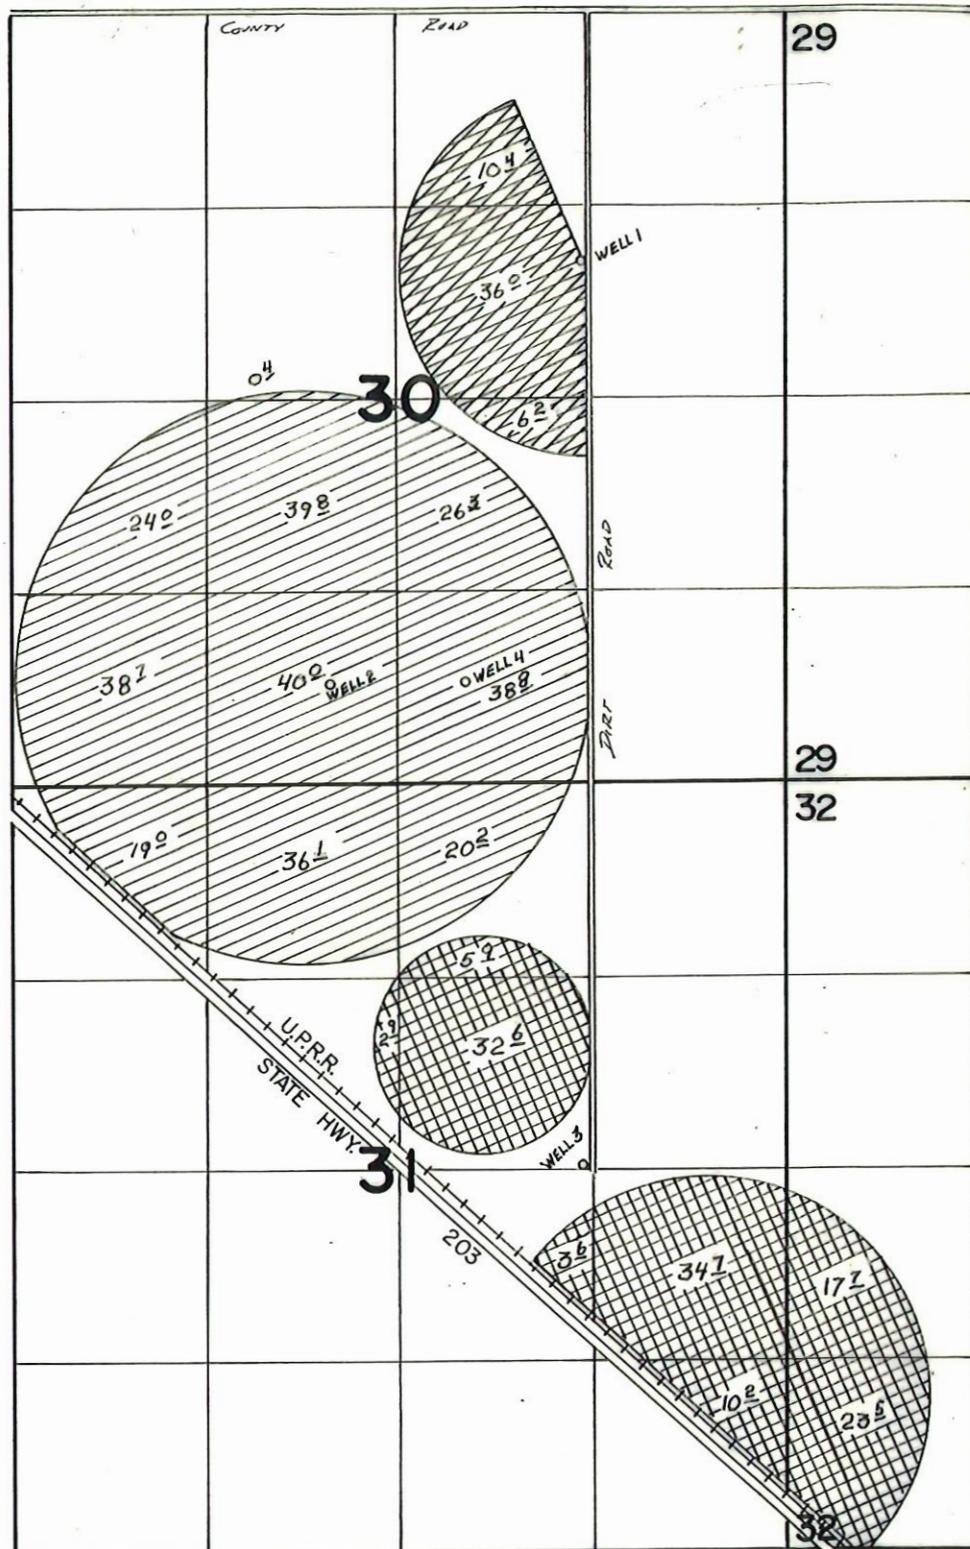

SCALE
1"=1320'



WELL 1

WELL 1 LOCATED 1710'S. AND 1380'W. FROM NE. COR. SEC. 30



WELLS 2, 4

WELL 2 LOCATED 4620'S. AND 3110'W. FROM NE. COR. SEC. 30
WELL 4 LOCATED 4610'S. AND 2190'W. FROM NE. COR. SEC. 30



WELL 3

WELL 3 LOCATED 7940'S. AND 1380'W. FROM NE. COR. SEC. 30

FINAL PROOF SURVEY
UNDER

Application No. G-9747.. Permit No. G-8881.....
IN NAME OF

UNION COUNTY RANCHES.....

Surveyed Aug. 5..... 1985 by V.L. CHURCH.....