


Section 14 T.4S., R.1E., W.M.

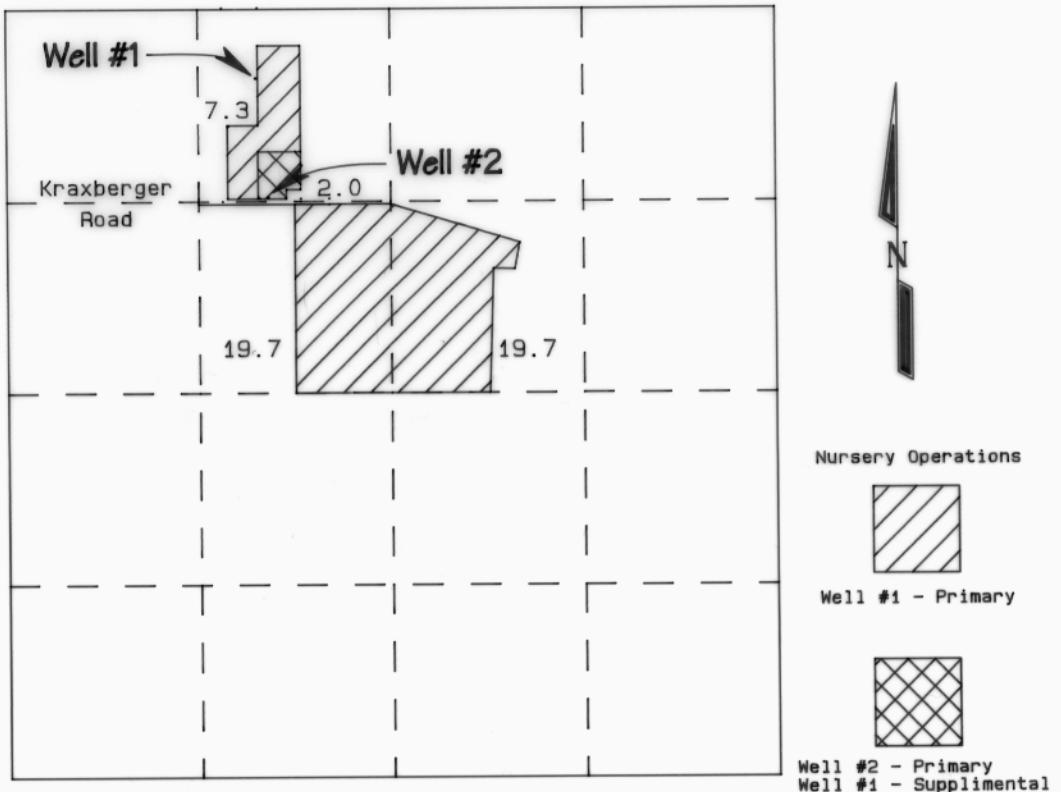

Scale 1" = 1320'.
Well #1 is located 475'S and 1718'E from the NW corner of Section 14.
Well #2 is located 1290'S and 1800'E from the NW corner of Section 14.

BENEFICIAL USE MAP
FOR
REBECCA RICHARDSON

PERMIT NO. G 11905

THE PREPARATION OF THIS MAP IS FOR THE
PURPOSE OF IDENTIFYING THE LOCATION
OF THE WATER RIGHT ONLY AND HAS NO
INTENT TO PROVIDE DIMENSIONS OR LOCATION
OF PROPERTY OWNERSHIP LINES.

