 
 


T. 5 S., R.5 W., W.M.

Location: The NE 1/4, SE 1/4, NW 1/4 & SW 1/4 of the NE 1/4 and The NE 1/4, NW 1/4 & SW 1/4 of the SE 1/4 and the NE 1/4, SE 1/4, NW 1/4 & SW 1/4 of the SW 1/4 and The NE 1/4, SE 1/4 & SW 1/4 of the NW 1/4 of Section 9, The SW 1/4 of the NW 1/4 and The NW 1/4 of the SW 1/4 of Section 10, The SE 1/4 of the SE 1/4 of Section 4, The NW 1/4 of the NW 1/4 of Section 16, T. 5 S., R.5 W., W.M., Yamhill County, OR

LEGEND:

-  = Tax Lot Line
-  = Property line
-  = D.L.C. line
-  = Section line
-  = "40" line
-  = Irrigation Mainlines, 4", 3" & 2" PVC, HDPE
-  = Unnamed Intermittent Stream
-  = Surface Water Appl. S-84126, Primary
-  = Ground Water Appl. G-15085, Supplemental
-  = Ground Water Appl. G-15085, Primary

Surface water sources
unnamed tributaries of the
South Yamhill River

RECEIVED

SEP 07 2016

WATER RESOURCES DEPT
SALEM, OREGON Scale: 1" = 660'

CLAIMS OF BENEFICIAL USE MAP

UNDER

S-84126

S-53672

Application No. G-15085


Permit No. G-13990

IN NAME OF

MOMTAZI FAMILY, LLC

Surveyed July, 2015

Note: This map is not intended to provide legal dimensions or locations of property ownership lines.

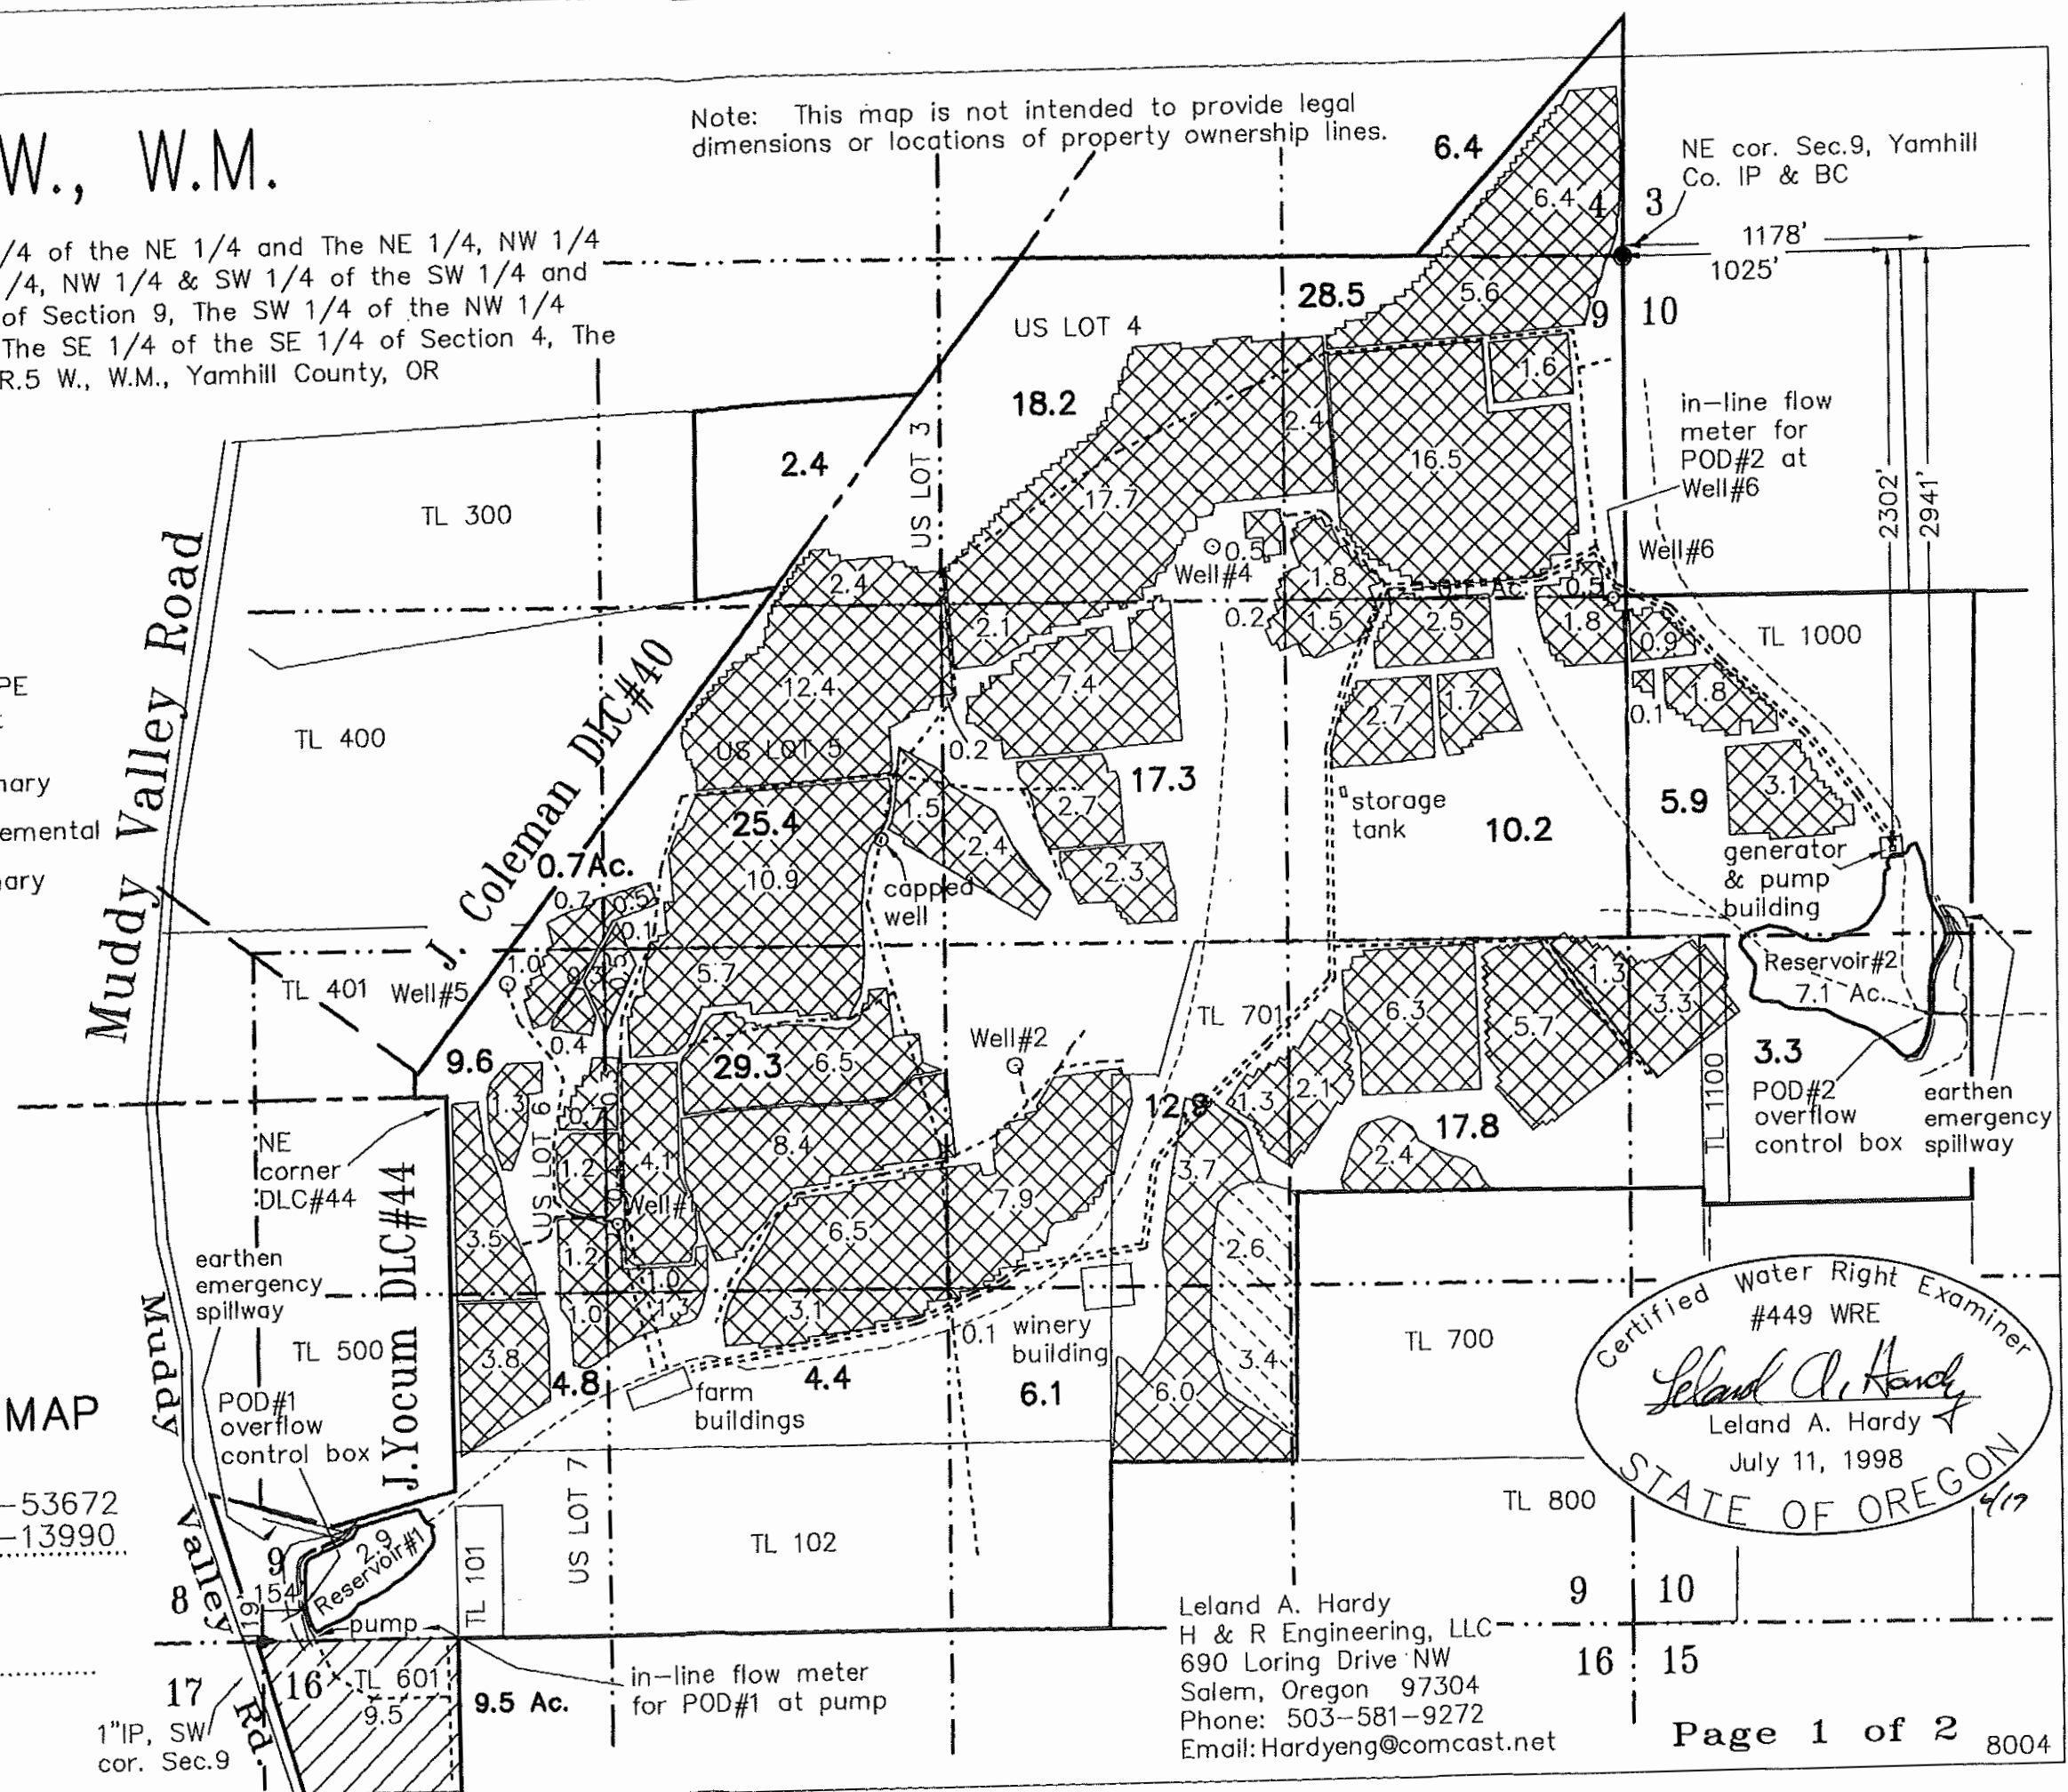

Certified Water Right Examiner
#449 WRE
Leland A. Hardy
Leland A. Hardy
July 11, 1998
STATE OF OREGON

Leland A. Hardy
H & R Engineering, LLC
690 Loring Drive NW
Salem, Oregon 97304
Phone: 503-581-9272
Email: Hardyeng@comcast.net

T. 5 S., R.5 W., W.M.

Location: The NE 1/4, SE 1/4, NW 1/4 & SW 1/4 of the NE 1/4 and The NE 1/4, NW 1/4 & SW 1/4 of the SE 1/4 and the NE 1/4, SE 1/4, NW 1/4 & SW 1/4 of the SW 1/4 and The NE 1/4, SE 1/4 & SW 1/4 of the NW 1/4 of Section 9, The SW 1/4 of the NW 1/4 and The NW 1/4 of the SW 1/4 of Section 10, The SE 1/4 of the SE 1/4 of Section 4, The NW 1/4 of the NW 1/4 of Section 16, T. 5 S., R.5 W., W.M., Yamhill County, OR

WELL TABLE - POA

Well	North-South	East-West	From Section Corner	Flow Meter Location
Well #1	1584'N	1390'E	SW corner of Section 9	at well head
Well #2	2170'N	2370'W	SE corner of Section 9	at well head
Well #3	N/A	N/A	N/A	N/A
Well #4	1115'S	1596'W	NE corner of Section 9	well not used
Well #5	2510'N	980'E	SW corner of Section 9	at well head
Well #6	1320'S	48'W	NE corner of Section 9	at well head

POND TABLE - POD

Pond	North-South	East-West	From Section Corner	Flow Meter Location
Pond #1	119'N	154'E	SW corner of Section 9	at pump
Pond #2	2941'S	1178'E	NE corner of Section 9	at well #6

Leland A. Hardy
H & R Engineering, LLC
690 Loring Drive NW
Salem, Oregon 97304
Phone: 503-581-9272
Email: Hardyeng@comcast.net

CLAIMS OF BENEFICIAL USE

RECEIVED

SEP 07 2016

UNDER
S-84126 S-53672
Application No. G-15085 Permit No. G-13990

WATER RESOURCES DEPT
SALEM, OREGON

IN NAME OF

MOMTAZI FAMILY, LLC

Surveyed July, 2015

Page 2 of 2

