


RECEIVED

AUG 03 2022


OWRD

CLAIM OF BENEFICIAL USE MAP FOR STEVEN & DEBORAH WEAVER

SECTIONS 13, TOWNSHIP 39 SOUTH,
RANGE 19 EAST, W.M.
LAKE COUNTY, OREGON

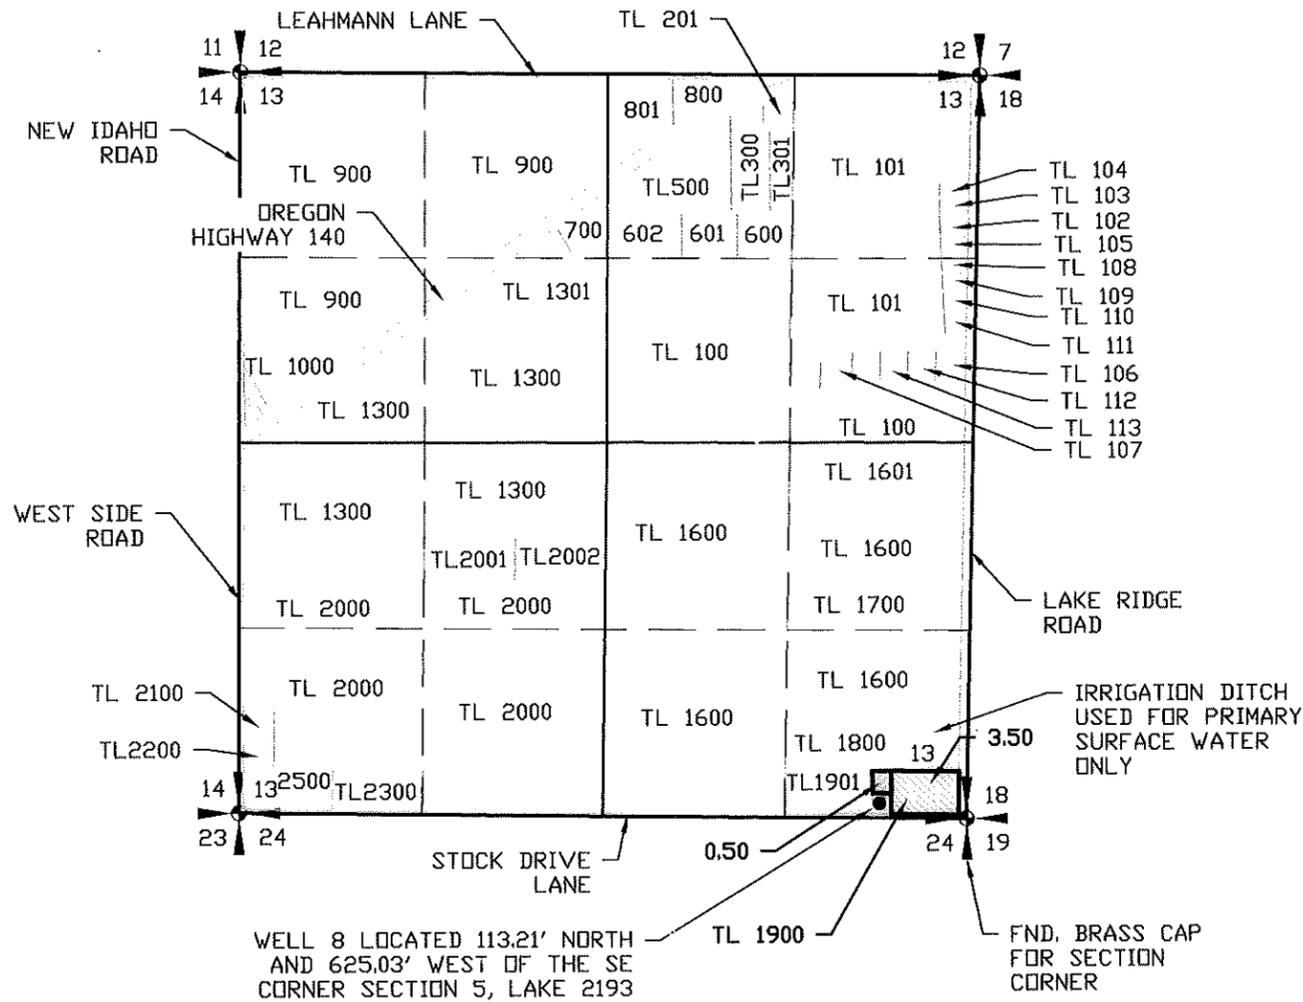

- PLACE OF USE - PRIMARY - 0.50 ACRES
- PLACE OF USE - SUPPLEMENTAL - 3.50 ACRES

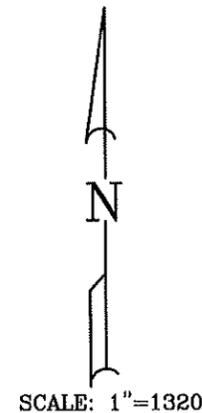

RENEWAL 12/31/23

LEGEND

- SECTION LINE
- 1/4 SECTION LINE
- 1/16 SECTION LINE
- TAXLOT LINE
- IRRIGATION DITCHES

APPLICATION NO. G-15545

PERMIT NO. G-15169

NOTE:
PREPARATION OF THIS MAP IS FOR IDENTIFYING PROPOSED WATER RIGHTS ONLY. IT HAS NO INTENT TO PROVIDE LOCATIONS OR DIMENSIONS OF PROPERTY BOUNDARIES.

REVISION	BY

ANDERSON ENGINEERING AND SURVEYING, INC.
 P.O. BOX 28
 LAKEVIEW, OREGON 97630
 (541) 947-4407/FAX: 947-2321
 WWW.ANDERSONENGINEERING.COM

FOR:
STEVEN & DEBORAH WEAVER
 94945 STOCK DRIVE LN
 LAKEVIEW, OR 97630
 (415) 812-0177

CLAIM OF BENEFICIAL USE MAP
APPLICATION G-15545
PERMIT G-15169

DATE:	7/19/2022
SCALE:	1" = 1320'
DWG. BY:	R.C.
JOB:	2022-120
FILE:	2022-120
SHEET:	1 OF 1