

MAP FOR CLAIM OF BENEFICIAL USE FOR
BRANTAN WALKER

ALL WITHIN FOUR QUARTERS OF SECTION 1, T5S, R1W, W.M.
 CLACKAMAS COUNTY
 APPLICATION G-17006 PERMIT G-16605

RECEIVED
 SEP 09 2022

RECEIVED

AUG 12 2022

OWRD

OWRD

THEORETICAL CENTER
 OF SECTION 1


CLACKAMAS
 COUNTY TAX LOT
 51W01 00700
 BOUNDARY

SE 1/4 OF NW 1/4
 SEC. 1
 SW 1/4 OF NE 1/4
 SEC. 1

POA-1 LOCATED
 2542 FEET NORTH
 AND 2831 FEET EAST
 OF THE SW CORNER
 OF SECTION 1.
 METER IN SAME
 BUILDING.

NE 1/4 OF SW 1/4
 SEC. 1
 NW 1/4 OF SE 1/4
 SEC. 1

NORTH

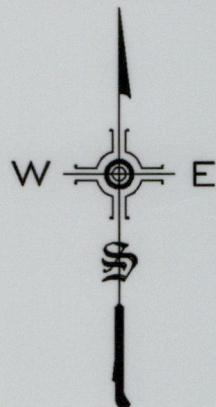


IRRIGATED AREA
 BY QUARTER SECTION


QUARTER	AREA
SW OF NE	8.03 AC
SE OF NW	5.16 AC
NE OF SW	3.21 AC
NW OF SE	2.47 AC
TOTAL	18.87 AC

2 1 SW COR SEC. 1
 111 12 2831 FEET EAST

2542 FEET NORTH

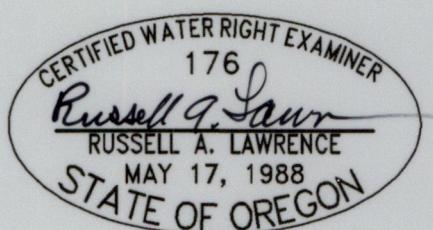

GRAPHIC SCALE

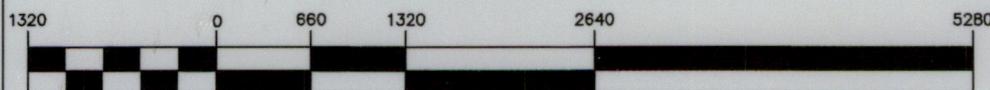

(IN FEET)
 1 inch = 1320 ft.

THIS MAP IS NOT INTENDED TO PROVIDE
 LEGAL DIMENSIONS OR LOCATIONS OF
 PROPERTY OWNERSHIP LINES.

 STREAM Fix
 19478 STARVIEW LANE
 OREGON CITY, OR 97045
 (503) 781-4885