


COBU MAP # 1236

CLAIM OF BENEFICIAL USE MAP

TO ADD A POINT OF APPROPRIATION
FOR T-11922
MOSBY FAMILY TRUST

SECTION 7, TOWNSHIP 31 SOUTH, RANGE 8 EAST, W.M.
TAX LOT: 1800

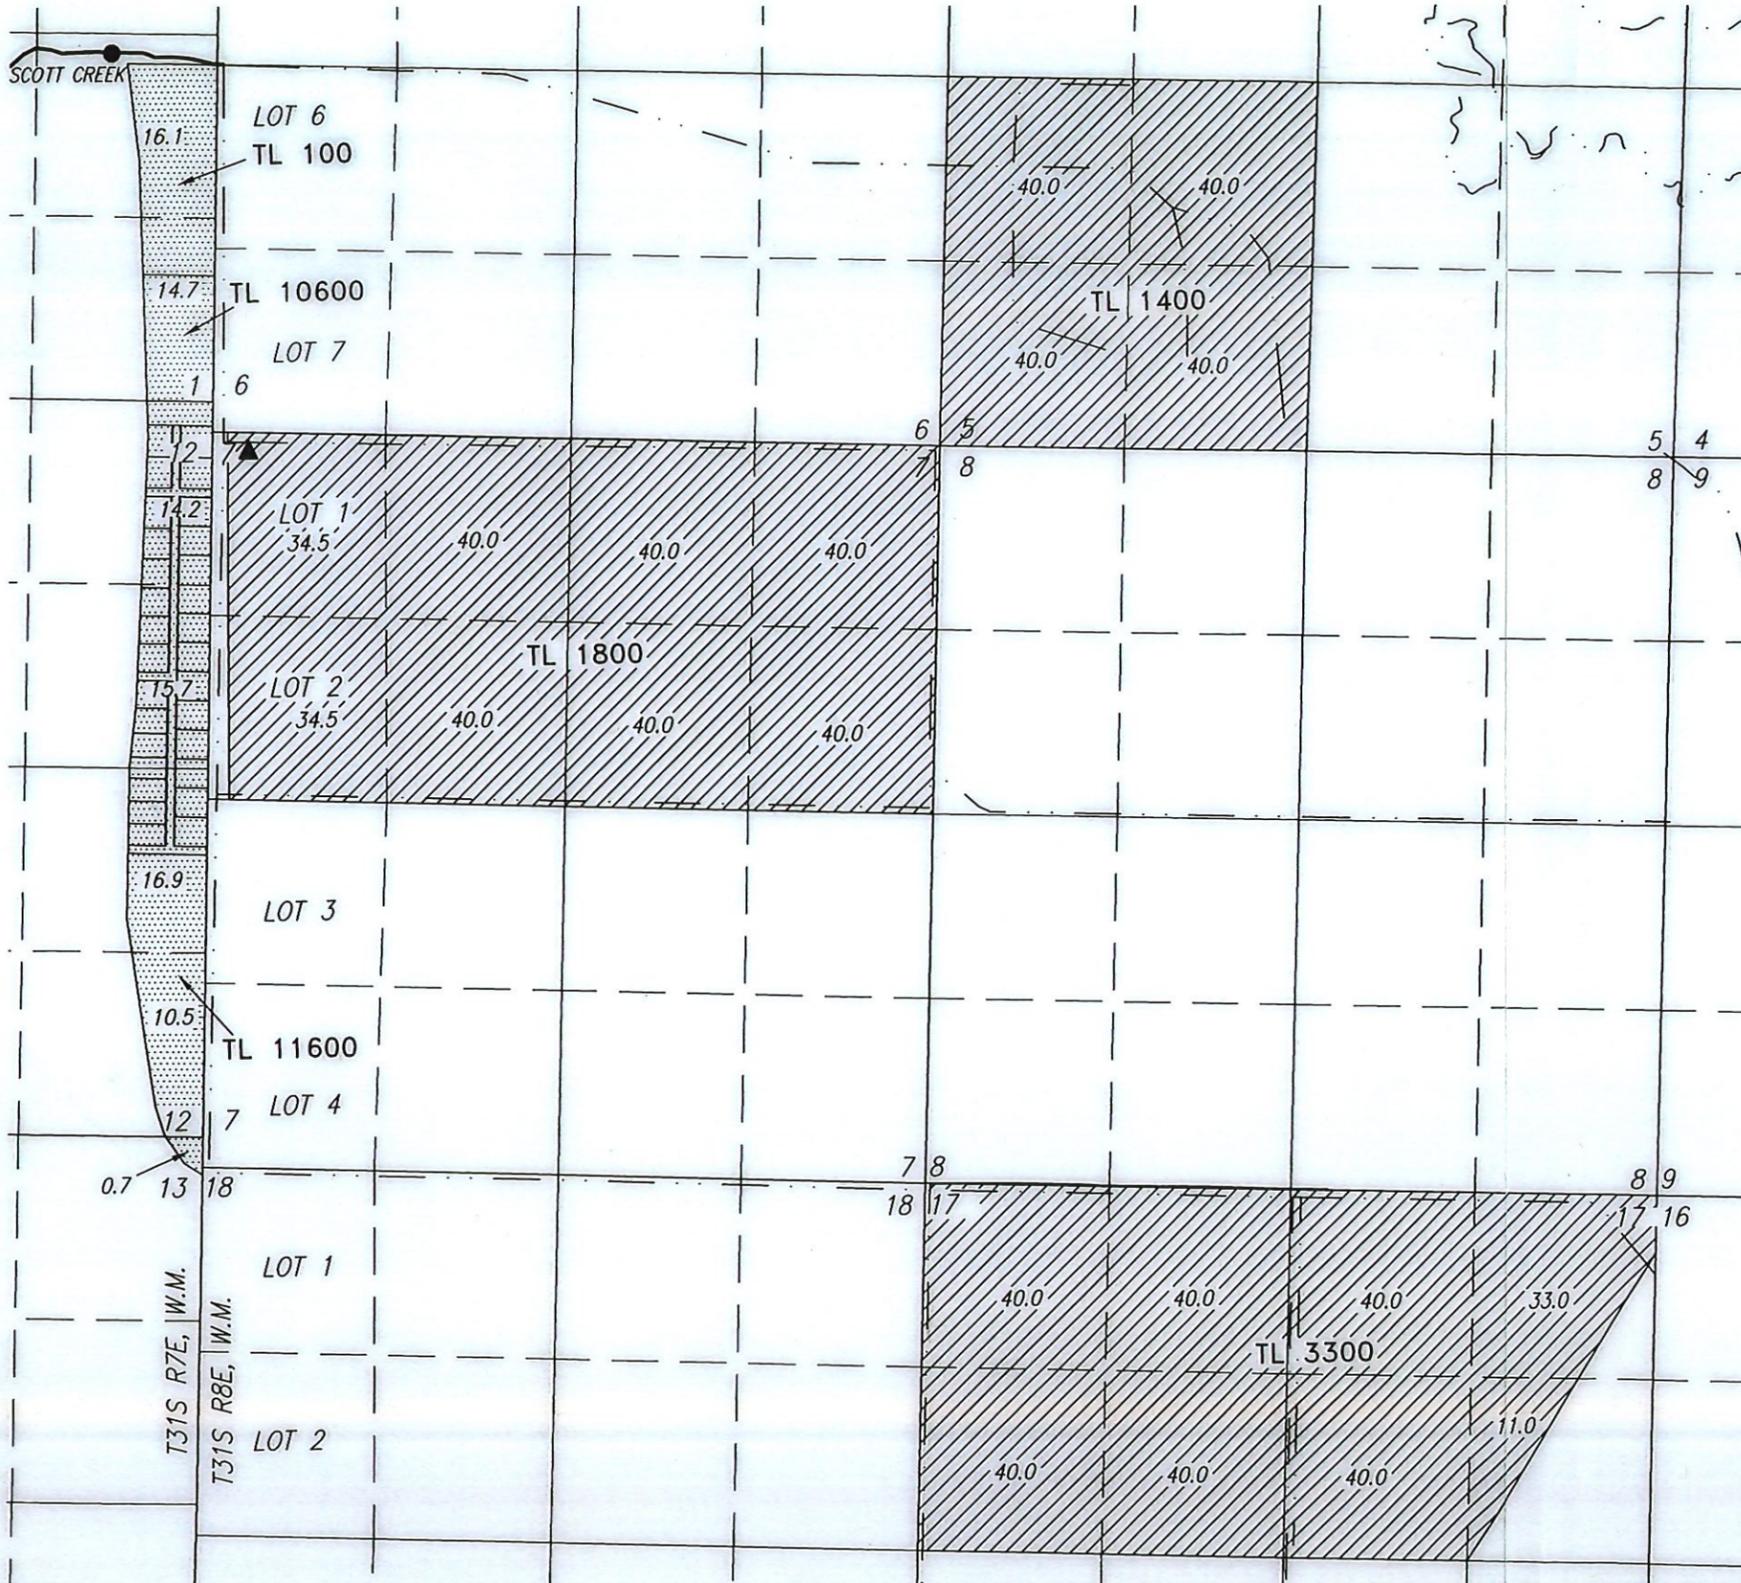


CANAL

- YAMSAY #2 - (KLAM 50590)
NE 1/4 SE 1/4 SEC 1 T31S R7E
70' N & 760' W FROM W 1/4 CORNER SEC 6 T31S R8E.
- ▲ BAR Y #1 - (KLAM 59411)
NW 1/4 NW 1/4 SEC 7 T31S R8E
140' S & 250' E FROM NW CORNER
FLOWMETER LOCATED 11' EAST FROM WELL

RECEIVED
JUN 15 2020
OWRD

- 753.0 ACRES SUPPLEMENTAL IRRIGATION FROM T-11922
- 88.8 ACRES SUPPLEMENTAL IRRIGATION FROM C-90001

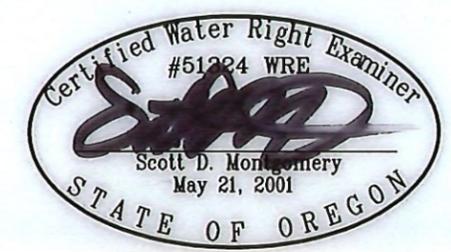

RENEWAL DATE: 12/31/2020

THIS MAP IS FOR THE PURPOSE OF LOCATING A WATER RIGHT ONLY AND HAS NO INTENT TO PROVIDE LEGAL DIMENSIONS OR THE LOCATION OF PROPERTY LINES

PREPARED FOR:
MOSBY FAMILY TRUST
294 BITTERROOT DRIVE
LEWISTOWN, MT 59457

PREPARED BY:
 ALL POINTS ENGINEERING AND SURVEYING, INC.
P.O. BOX 767 TERREBONNE, OR 97760
(541) 548-5833 www.APEandS.com