


**T27S R32E, SECTION 6
T27S R31E, SECTION 1, WM#**

HARNEY COUNTY, OREGON

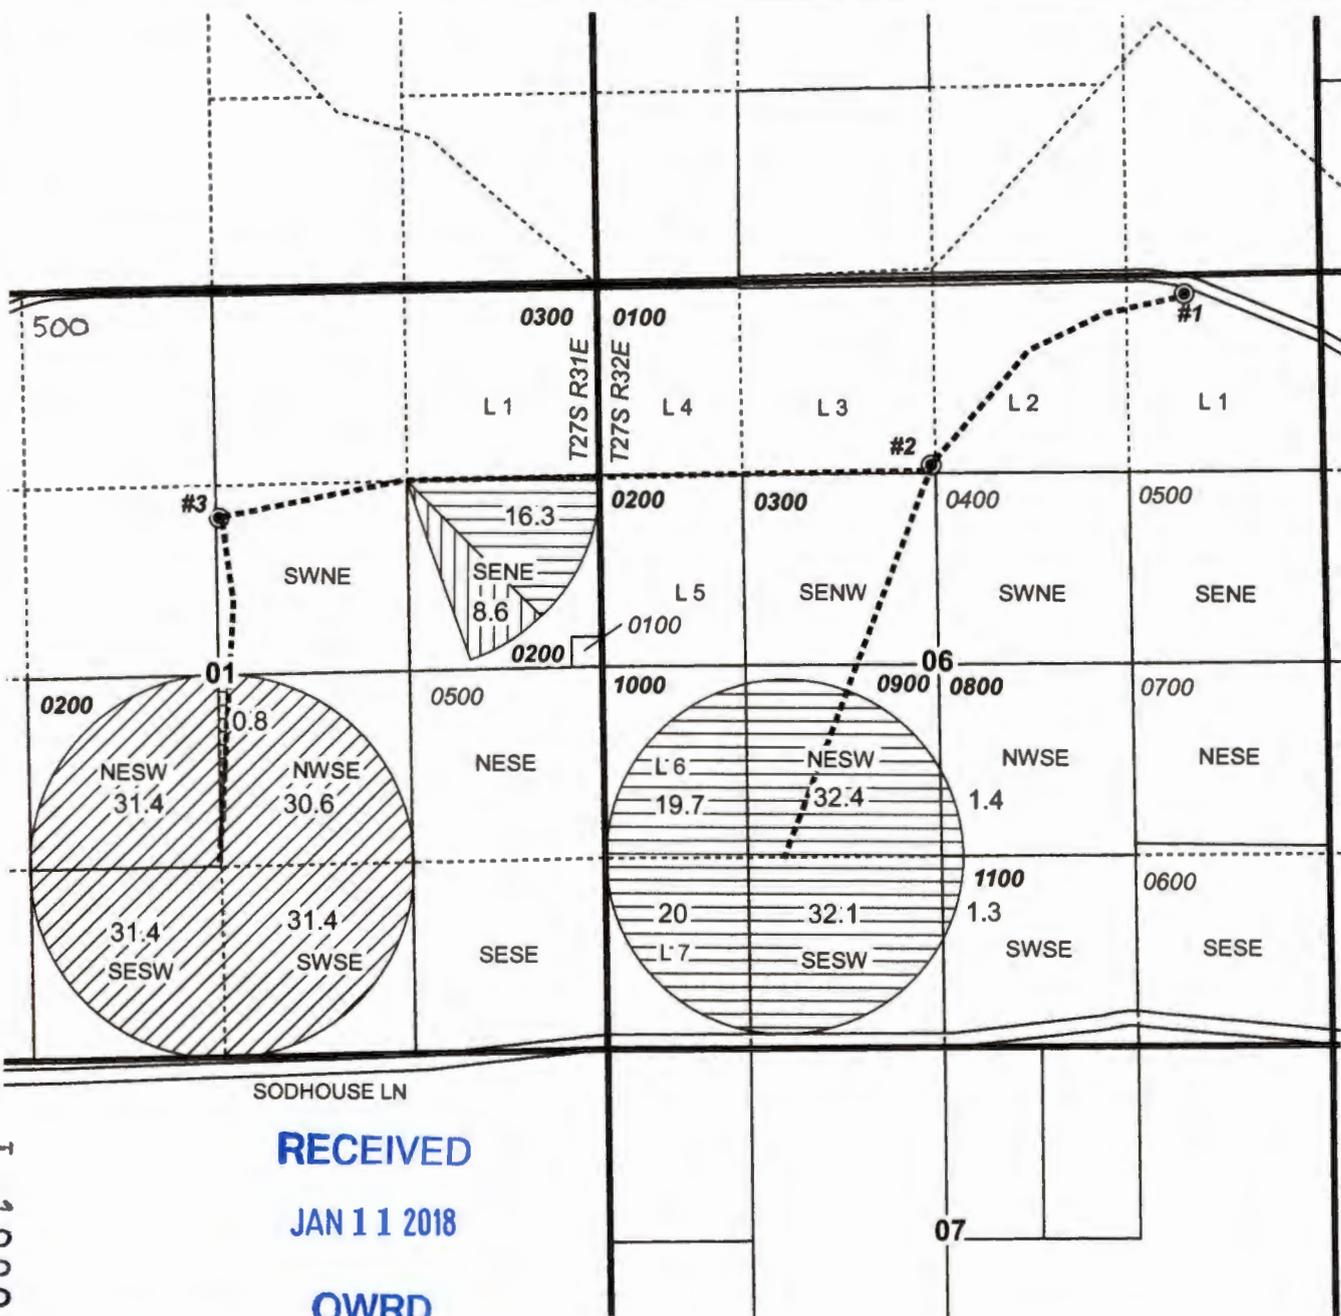

1" = 1,320'

CERT 62014

CERT 93234

CERT 93194

Well & Meter

Quarter Quarter

Tax Lot

Section

Pipeline

- WELL & METER LOCATIONS:**
- #1: 125' S, 915' W OF NE 1/4 COR S6
 - #2: 1,280' S, 1' W OF N 1/4 COR S6
 - #3: 1,542' S, 21' E OF N 1/4 COR S1



RENEWAL DATE 12/31/2018

RECEIVED
JAN 11 2018
OWRD

T 12822

TRANSFER "ON" MAP
Golden Rule Farms, Inc. / Briggs Property

CERTIFICATES 62014, 93194 & 93234

NOTE: THIS MAP IS NOT INTENDED TO PROVIDE LEGAL DIMENSIONS OR LOCATIONS OF PROPERTY OWNERSHIP LINES.

NOV 27, 2017

WATER RIGHT SERVICES, LLC
PO BOX 1830, BEND, OR 97709
CCB# 197121 www.oregonwater.us
541-389-2837 JOHNSHORT@USA.COM

**T25S, R31E,
SECTION 31, WM**

HARNEY COUNTY, OREGON




1 inch = 1,320 feet



-  CERT 93194 OFF
-  CERT 93234 OFF
-  CERT 62014 OFF
-  CERT 62014 Remaining
-  Section
-  Quarter Quarter
-  Tax Lot
-  Well



RENEWAL DATE 12/31/2018

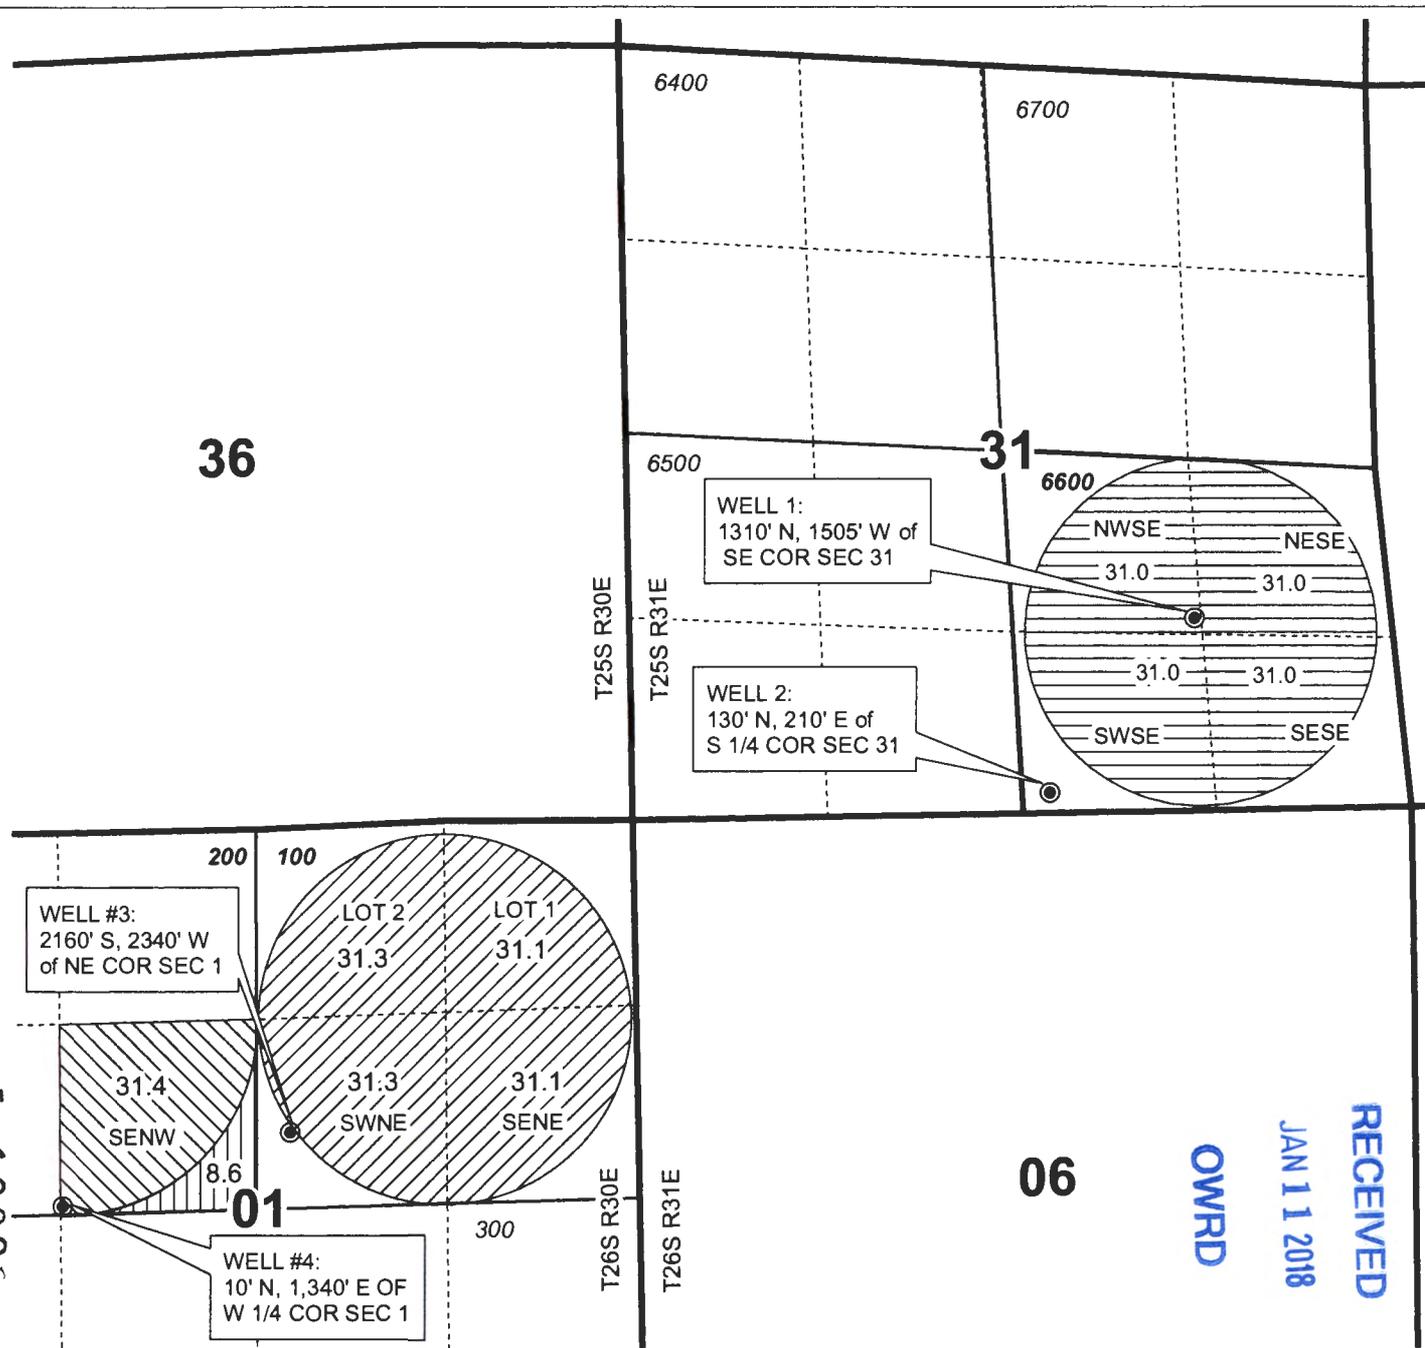

06

OWRD

JAN 11 2018

RECEIVED

**Transfer "OFF" Map
Golden Rule Farms, Inc.**

CERTIFICATES 62014, 93194 & 93234

NOTE: THIS MAP IS NOT INTENDED TO
PROVIDE LEGAL DIMENSIONS OR LOCATIONS
OF PROPERTY OWNERSHIP LINES.

NOVEMBER 27, 2017

WATER RIGHT SERVICES, LLC
PO BOX 1830, BEND, OR 97709
CCB# 197121 www.oregonwater.us
541-389-2837 JOHNSHORT@USA.COM

CLAIM OF BENEFICIAL USE MAP


TO CHANGE PLACE OF USE AND POINT OF APPROPRIATION
PER T-12822 FOR GOLDEN RULE FARMS, INC.

SECTION 1, TOWNSHIP 27 SOUTH, RANGE 31 EAST, W.M.

TAX LOTS: 200 & 300

SECTION 6, TOWNSHIP 27 SOUTH, RANGE 32 EAST, W.M.


TAX LOTS: 900 & 1000

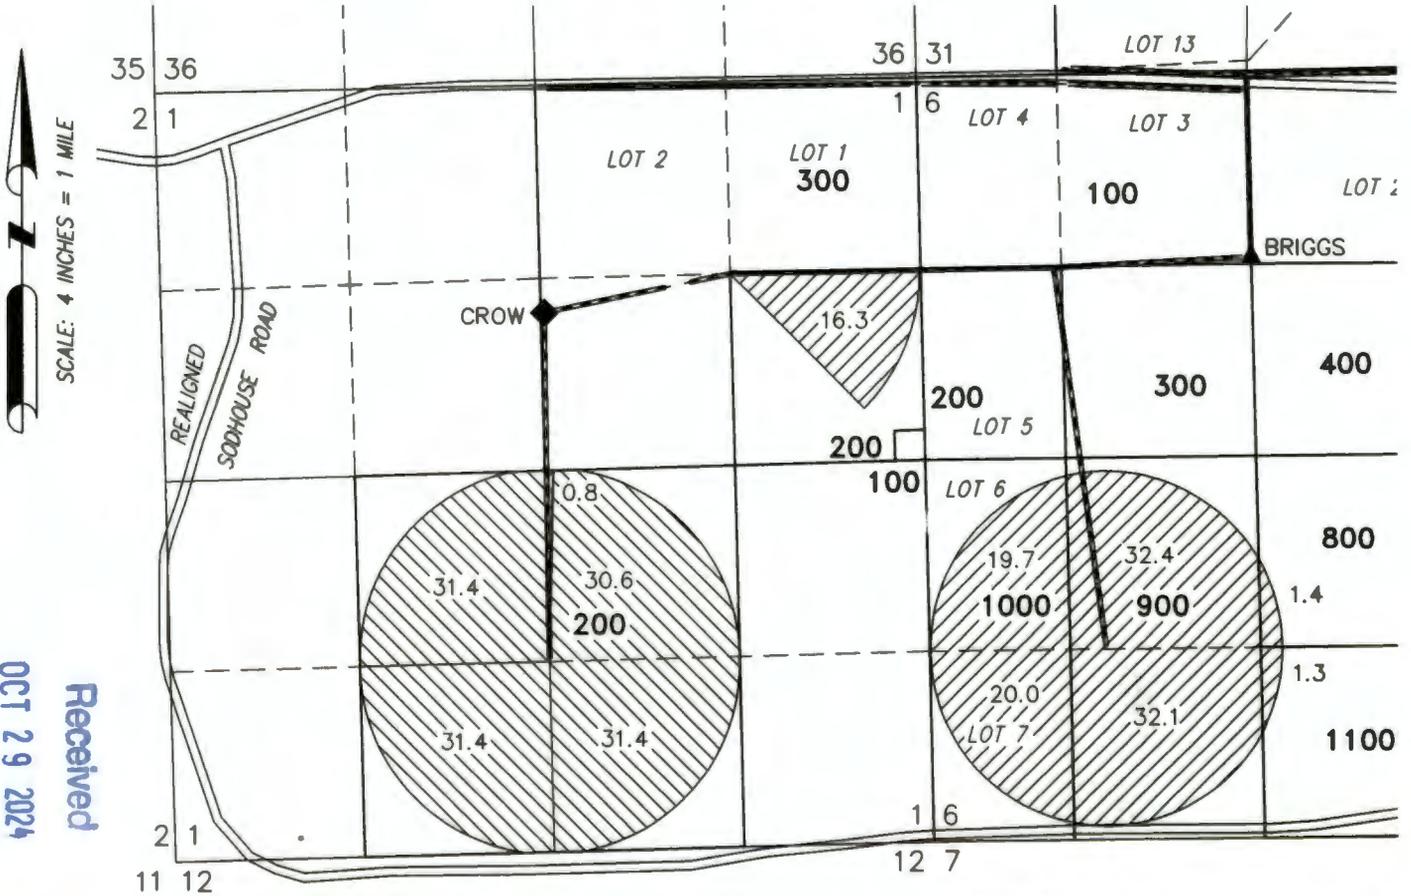

Received
 OCT 29 2024
 OWRD

◆ **WELL 3 CROW (HARN 1461)**
 LOCATED IN THE SW 1/4 NE 1/4 SECTION 1, T27S
 R31E, W.M. AND 1542 FEET SOUTH AND 21 FEET EAST
 FROM THE N 1/4 CORNER OF SECTION 1.
 FLOW METER IS LOCATED 4.0' SOUTH FROM WELL.

▲ **WELL 2 BRIGGS (HARN 1460)**
 LOCATED IN THE NE 1/4 NW 1/4 LOT 3) SECTION 6,
 T27S R.32E, W.M. AND 1280 FEET SOUTH AND 1 FEET
 WEST FROM THE N 1/4 CORNER OF SECTION 6.
 FLOW METER IS LOCATED 4.0' WEST FROM WELL.

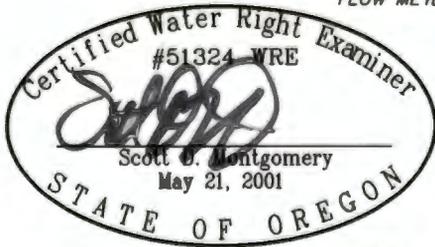

- 124.0 ACRES IR FROM WELLS 2 & 3 (G-17514), AS SHOWN.
- 124.8 ACRES IR FROM WELLS 2 & 3 (G-13639), AS SHOWN.

THIS MAP IS FOR THE PURPOSE OF LOCATING A WATER RIGHT ONLY AND HAS NO INTENT TO PROVIDE LEGAL DIMENSIONS OR THE LOCATION OF PROPERTY LINES.

RENEWAL DATE: 12/31/2024

PREPARED FOR:

GOLDEN RULE FARMS, INC.
P.O. BOX 255
CHRISTMAS VALLEY, OR 97641

PREPARED BY:



ALL POINTS ENGINEERING AND SURVEYING, INC.
P.O. BOX 767
TERREBONNE, OR 97760
(541) 548-5833
www.APEandS.com