


Claim of Beneficial Use - Wand Application S-70924, Permit S-51507

Township 7S, Range 11W, W.M.

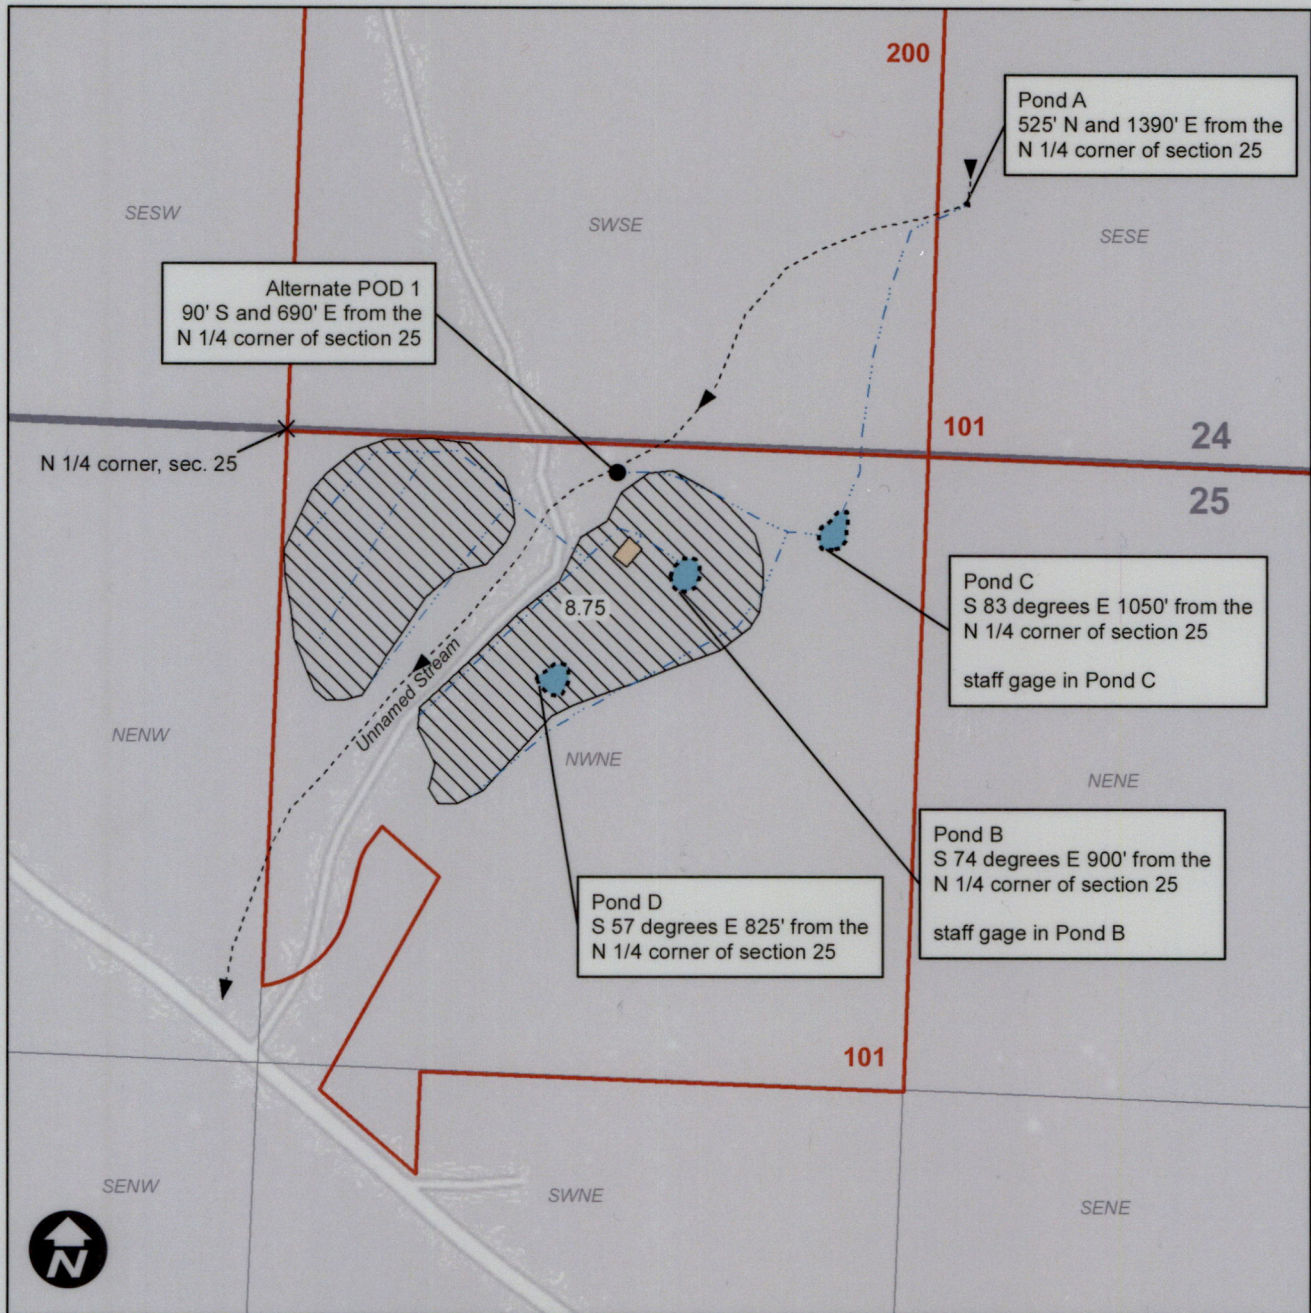

0 200 400 800 Feet

This map is not intended to provide legal dimensions or locations of property ownership lines.

Legend

- IR POU
- House
- Ponds
- Taxlots
- Pipeline

Received by OWRD

DEC 11 2024

Salem, OR

