


Claim of Beneficial Use - Wand Application R-72499, Permit R-11476

Township 7S, Range 11W, W.M.

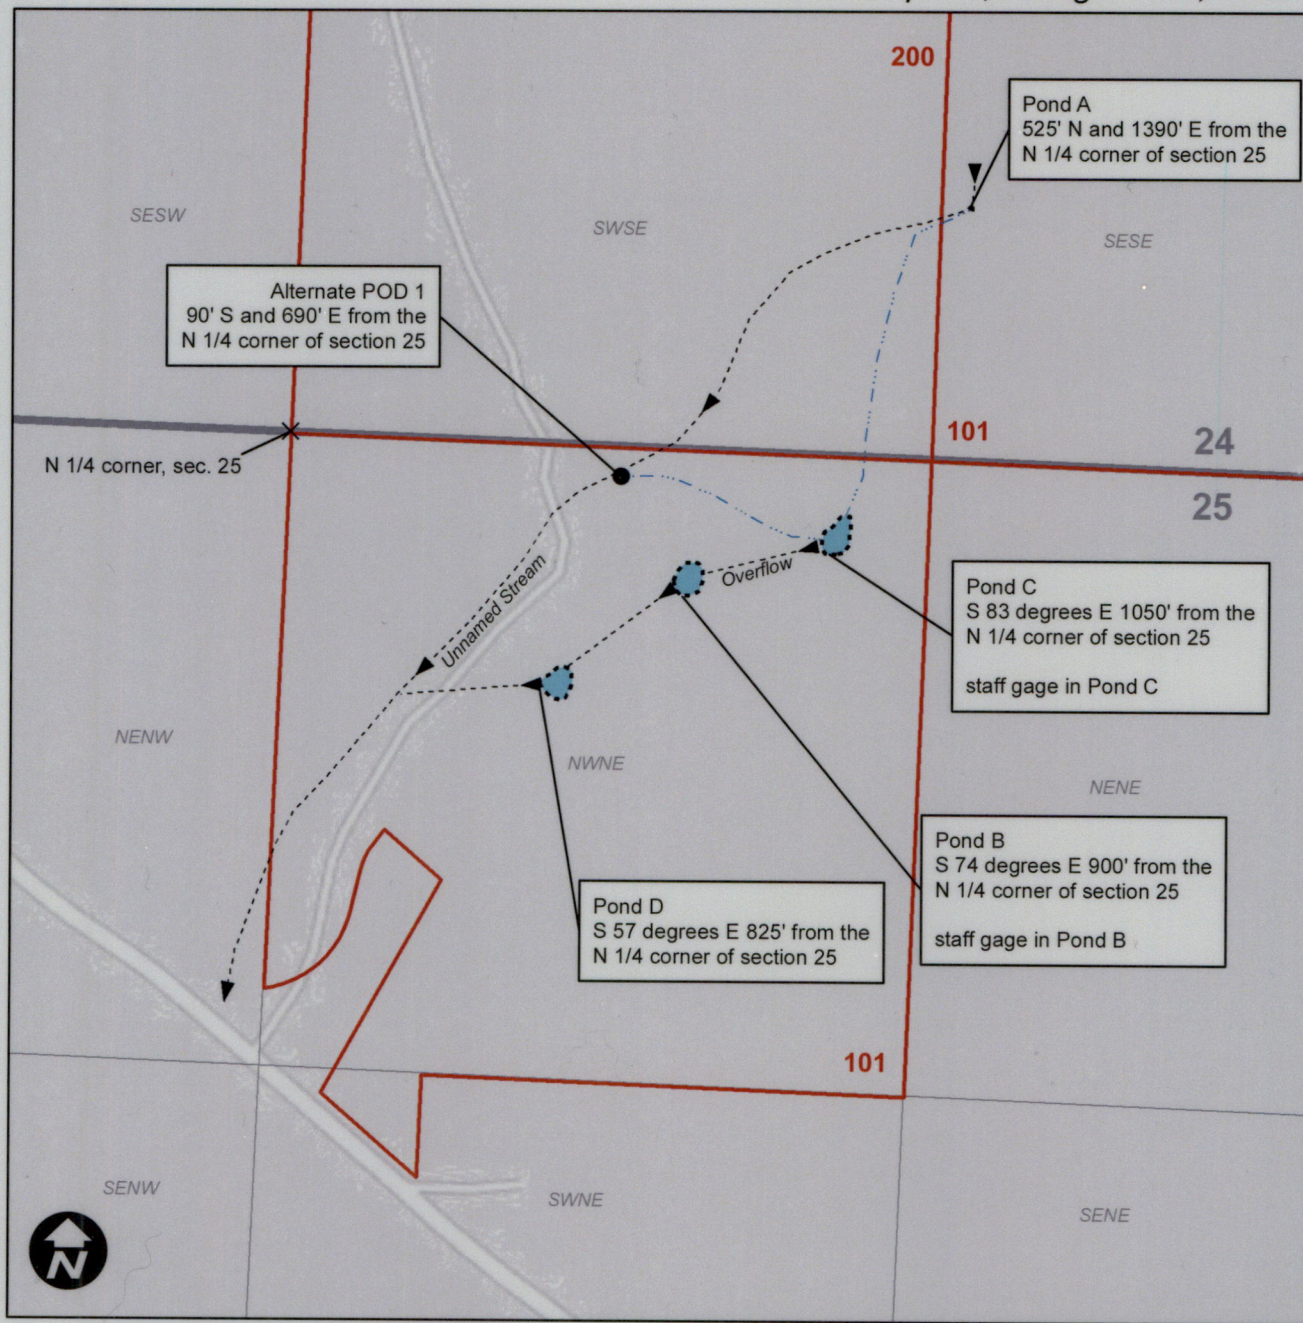

0 200 400 800 Feet

This map is not intended to provide legal dimensions or locations of property ownership lines.

Legend

Pipeline Ponds Taxlots



Received by CWRD

DEC 11 2021

EXPIRES: 12-31-2026

Salem, OR