

original in S-72912

RECEIVED

FINAL PROOF SURVEY MAP IN THE NAME OF BOBBY LITTERELL

AUG 24 2000

WATER RESOURCES DEPT.
SALEM, OREGON



APPLICATION R-72911
S-72912

PERMIT R-11807
52289

SECTIONS 16, 21 & 22, TOWNSHIP 32 SOUTH, RANGE 15 WEST, W.M.



THE PURPOSE OF THIS MAP IS TO IDENTIFY THE LOCATION OF THE WATER RIGHT. IT IS NOT INTENDED TO PROVIDE INFORMATION RELATIVE TO THE LOCATION OF PROPERTY OWNERSHIP BOUNDARY LINES.

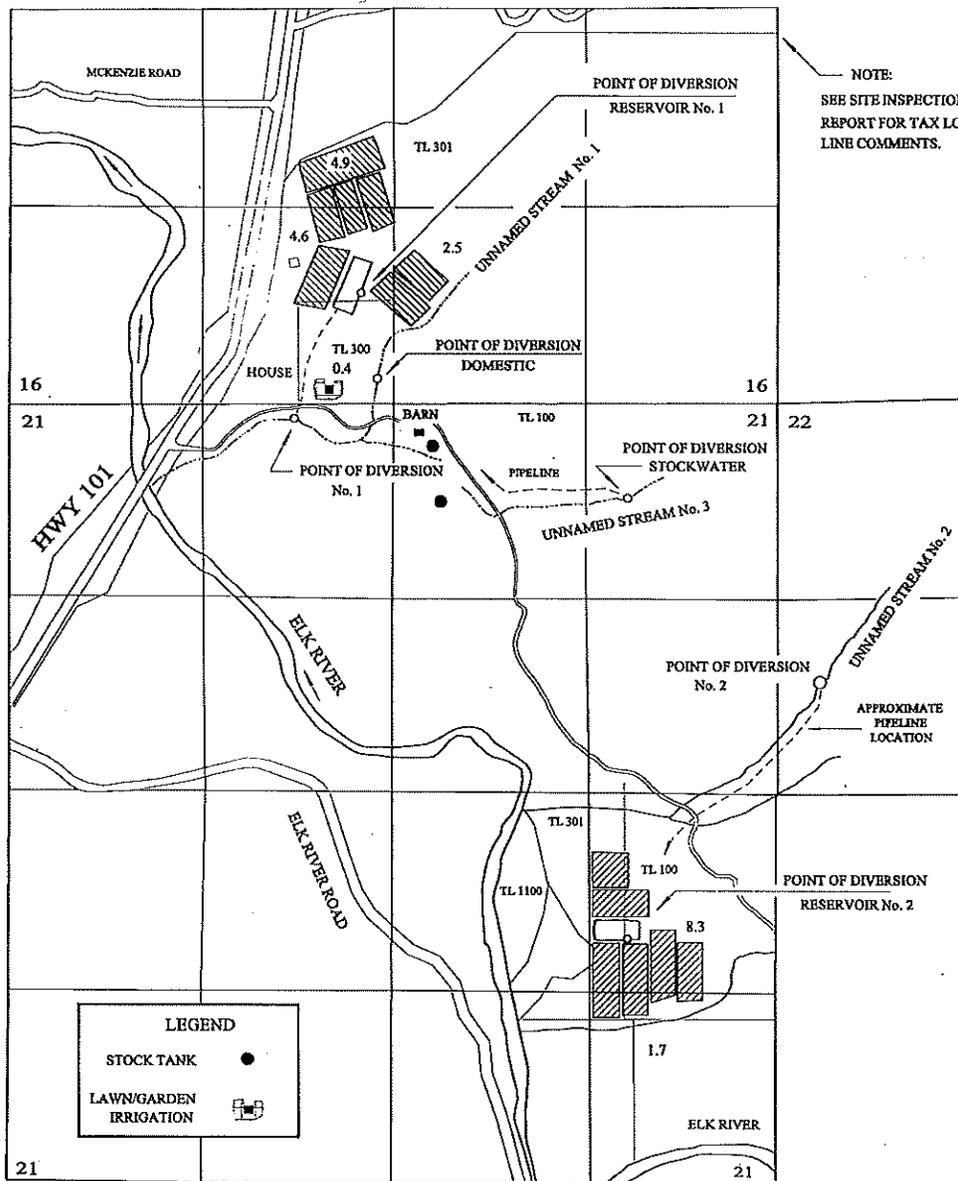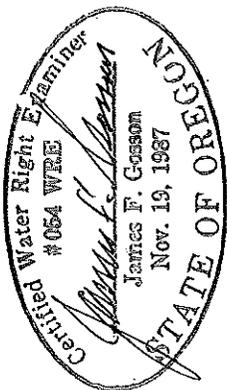

NOTE:
SEE SITE INSPECTION
REPORT FOR TAX LOT
LINE COMMENTS.

LEGEND

- STOCK TANK ●
- LAWN/GARDEN IRRIGATION [Symbol]

DIVERSION	SOURCE	NORTH/SOUTH	EAST/WEST	¼ ¼ SECTION	SECTION
DIVERSION No. 1	UNNAMED STREAM No. 1	115' SOUTH	3,330' WEST	NE¼NW¼	21
DIVERSION No. 2	UNNAMED STREAM No. 2	1,940' SOUTH	290' EAST	SW¼NW¼	22
RESERVOIR No. 1		760' NORTH	2,860' WEST	SE¼SW¼	16
RESERVOIR No. 2		3,720' SOUTH	1,040' WEST	NE¼SE¼	21
STOCKWATER	UNNAMED STREAM No. 3	670' SOUTH	1,030' WEST	NE¼NE¼	21
DOMESTIC	UNNAMED STREAM No. 1	160' NORTH	2,740' WEST	SE¼SW¼	16

ALL FROM THE NORTHEAST CORNER OF SECTION 21, TOWNSHIP 32 SOUTH, RANGE 15 WEST, W.M.; CURRY COUNTY