


AMENDED CLAIM OF BENEFICIAL USE MAP  
 APPLICATION S-72912, PERMIT S-52289 & APPLICATION R-72911, PERMIT R-11807  
 SECTIONS 16 & 21, TOWNSHIP 32 SOUTH, RANGE 15 WEST, W.M.  
 CURRY COUNTY, OREGON

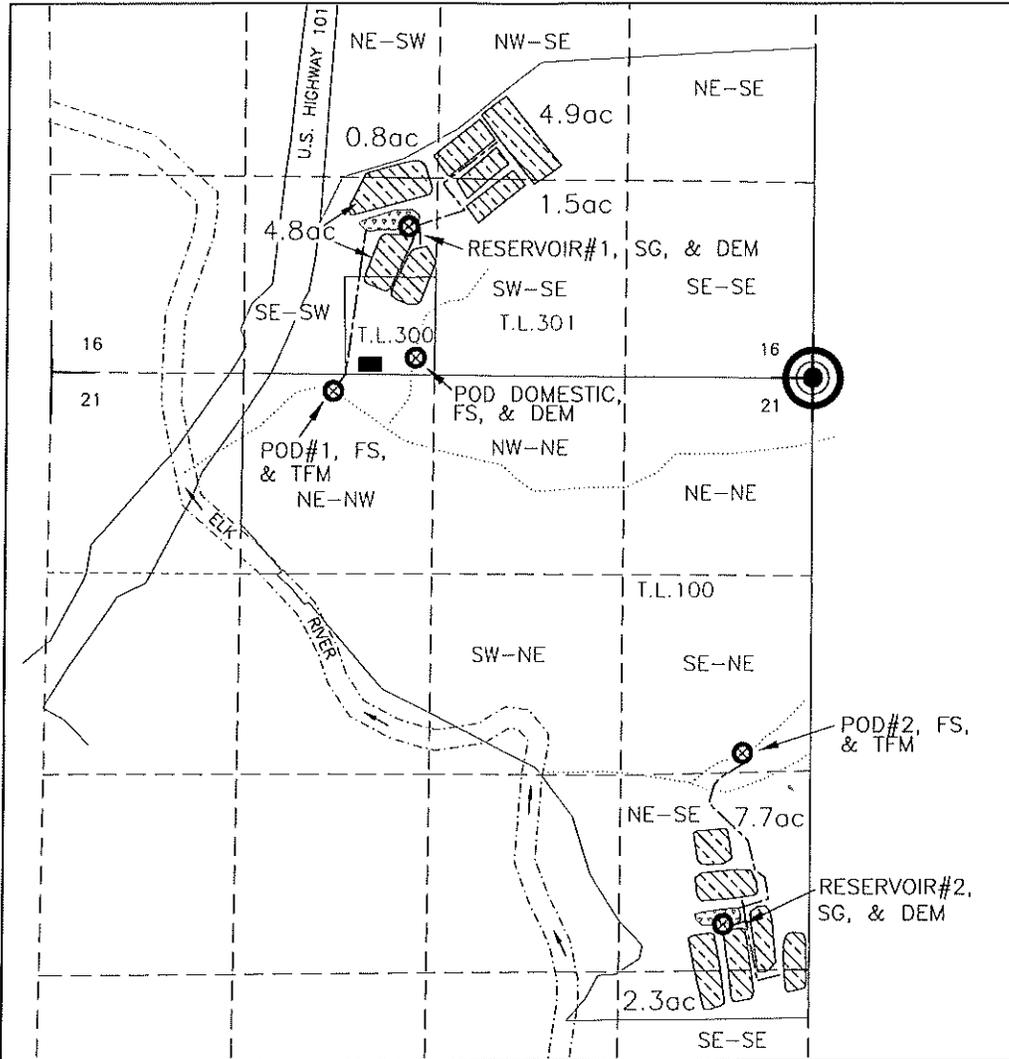


**LEGEND**


- REFERENCE CORNER (RC)**  
NE COR. OF SEC. 21, T.32S., R.15W., W.M.
- POINT OF DIVERSION (POD)**
- UNNAMED STREAM
- MAINLINE
- TAXLOTS
- 1/16TH SECTION LINES
- RESERVOIR**
- PLACE OF USE CRANBERRY BOGS**
- SINGLE FAMILY HOUSEHOLD**
- TOTALIZING FLOW METER - TFM**
- DEDICATED ELECTRIC METER - DEM**
- FISH SCREEN - FS**
- STAFF GAGE - SG**

POD	N./S.	E./W.	Q.-Q. SEC.	SECTION
POD#1	115' S.	3,330' W.	NE-NW	21
POD#2	2,576 S.	487' W.	SE-NE	21
DOMESTIC	160' N.	2,740' W.	SE-SW	16
RESERVOIR#1	760' N.	2,860' W.	SE-SW	16
RESERVOIR#2	3,754' S.	615' W.	NE-SE	21

ALL DISTANCES FROM RC

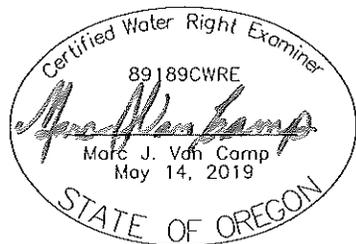

EXPIRES 06/30/2026

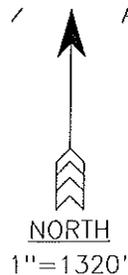

DISCLAIMER: THIS MAP WAS PREPARED FOR THE PURPOSE OF IDENTIFYING THE LOCATION OF WATER RIGHT ONLY AND IS NOT INTENDED TO PROVIDE LEGAL DESCRIPTIONS OR LOCATIONS OF PROPERTY LINES.



P.O. Box 995  
 Coos Bay, OR 97420  
 (541) 297-1880  
 vancompconsulting@gmail.com

Prepared For:  
 David Weiner  
 23151 Lorentz Rd.  
 Plymouth, CA 95669

Project:  
 AMENDED CLAIM OF BENEFICIAL USE

Date:  
 March 31, 2025