

T. 5 S., R.5 W., W.M.

Location: The NE 1/4, SE 1/4, NW 1/4 & SW 1/4 of the NE 1/4 and The NE 1/4, NW 1/4 & SW 1/4 of the SE 1/4 and the NE 1/4, SE 1/4, NW 1/4 & SW 1/4 of the SW 1/4 and The NE 1/4, SE 1/4 & SW 1/4 of the NW 1/4 of Section 9, The SW 1/4 of the NW 1/4 and The NW 1/4 of the SW 1/4 of Section 10, The SE 1/4 of the SE 1/4 of Section 4, The NW 1/4 of the NW 1/4 of Section 16, T. 5 S., R.5 W., W.M., Yamhill County, OR

Note: This map is not intended to provide legal dimensions or locations of property ownership lines.

LEGEND:

- = Tax Lot Line
- = Property line
- = D.L.C. line
- = Section line
- = "40" line
- = Irrigation Mainlines, 4", 3" & 2" PVC, HDPE
- = Unnamed Intermittent Stream
- = Surface Water Appl. S-84126, Primary
- = Ground Water Appl. G-15085, Supplemental
- = Ground Water Appl. G-15085, Primary

Surface water sources unnamed tributaries of the South Yamhill River

Scale: 1" = 660'


CLAIMS OF BENEFICIAL USE MAP

UNDER
 S-84126 S-53672
 Application No. G-15085 Permit No. G-13990

IN NAME OF
 MOMTAZI FAMILY, LLC

Surveyed July, 2015

1" IP, SW
 cor. Sec.9

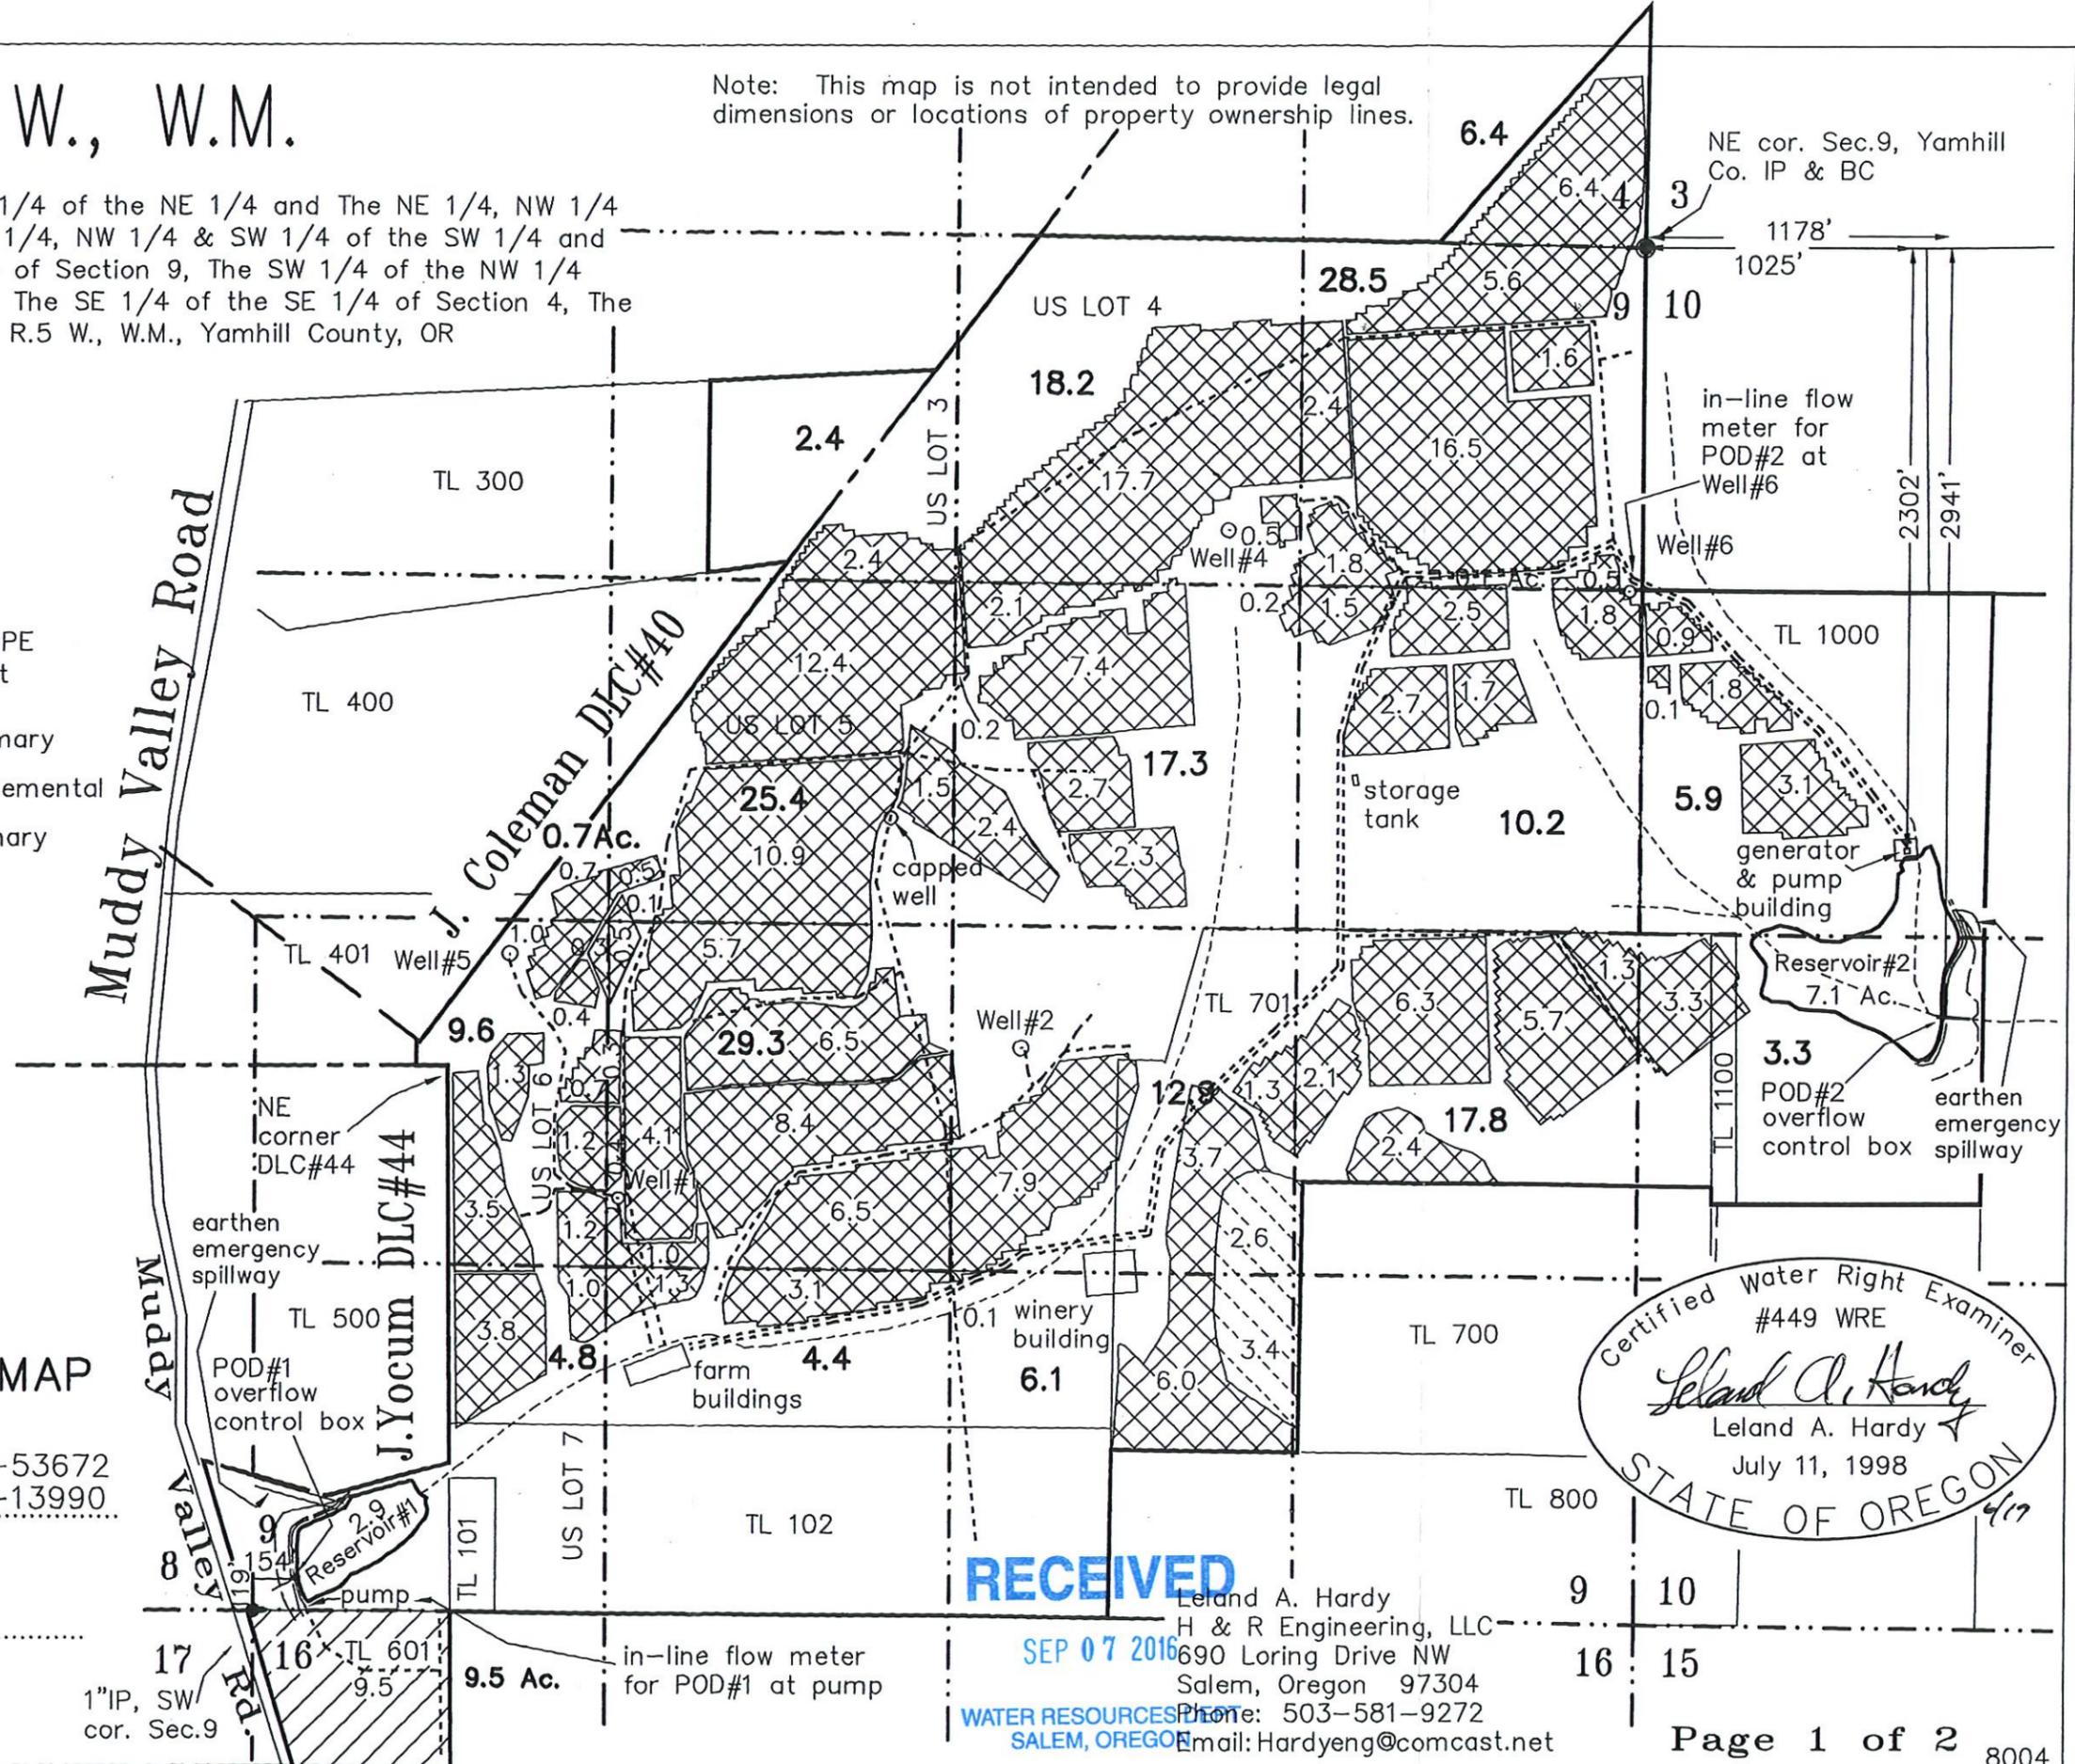

Certified Water Right Examiner
 #449 WRE
Leland A. Hardy
 Leland A. Hardy
 July 11, 1998
 STATE OF OREGON

RECEIVED

SEP 07 2016
 Leland A. Hardy
 H & R Engineering, LLC
 690 Loring Drive NW
 Salem, Oregon 97304
 Phone: 503-581-9272
 Email: Hardyeng@comcast.net