


# T. 5 S., R.5 W., W.M.

Location: SW 1/4 of the SW 1/4 of Section 9, NW 1/4 of the NW of Section 16,  
T. 5 S., R.5 W., W.M., Yamhill County, OR

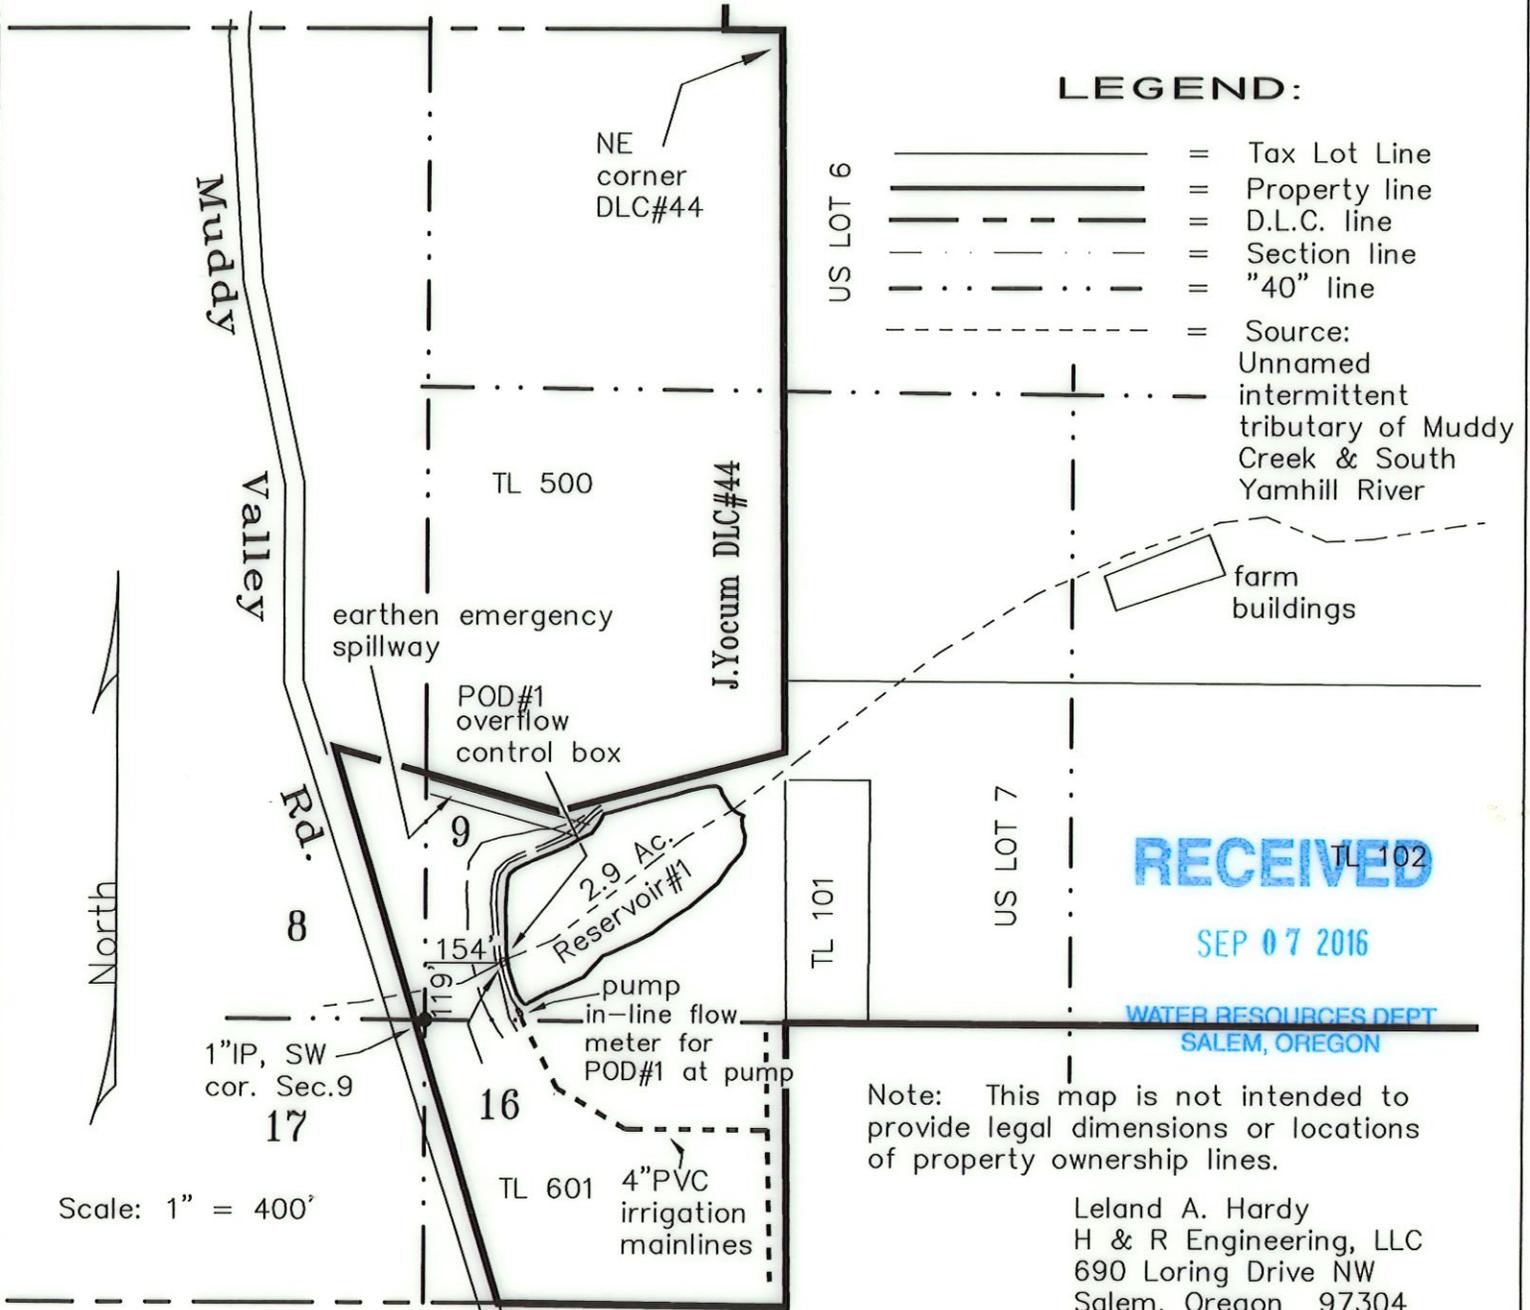

## LEGEND:

- = Tax Lot Line
- = Property line
- = D.L.C. line
- = Section line
- = "40" line
- = Source:  
Unnamed  
intermittent  
tributary of Muddy  
Creek & South  
Yamhill River

**RECEIVED**

SEP 07 2016

WATER RESOURCES DEPT  
SALEM, OREGON

Note: This map is not intended to provide legal dimensions or locations of property ownership lines.

Leland A. Hardy  
H & R Engineering, LLC  
690 Loring Drive NW  
Salem, Oregon 97304  
Phone: 503-581-9272  
Email: Hardyeng@comcast.net

Dam & Reservoir #1

## CLAIM OF BENEFICIAL USE MAP

UNDER

Application No. R-84127 Permit No. R-12823

IN NAME OF

MOMTAZI FAMILY, LLC

Surveyed July, 2015

