

RECEIVED

SEP 07 2016

WATER RESOURCES DEPT  
SALEM, OREGON

4

3

1178'

1025'

9

10

NE cor. Sec.9, Yamhill  
Co. IP & BC


T. 5 S., R.5 W., W.M.

Location: NW 1/4 of the SW 1/4, SW 1/4 of the NW 1/4 of Section 10,  
T. 5 S., R.5 W., W.M., Yamhill County, OR

LEGEND:

- = Tax Lot Line
- ===== = Property line
- = D.L.C. line
- = Section line
- = "40" line
- = Source: Unnamed intermittent tributary of South Yamhill River

Leland A. Hardy  
H & R Engineering, LLC  
690 Loring Drive NW  
Salem, Oregon 97304  
Phone: 503-581-9272  
Email: Hardyeng@comcast.net

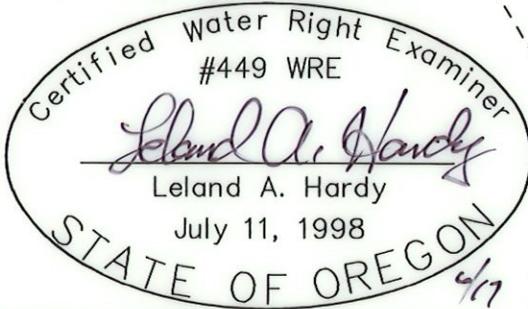

in-line flow meter  
for POD#2 at  
Well#6

Scale: 1" = 400'

Well#6

TL 1000

4"HDPE  
mainlines

generator &  
pump building

earthen emergency  
spillway

Reservoir#2  
7.1 Ac.

POD#2  
overflow  
control box

toe of dam

TL 701

Dam & Reservoir #2

CLAIM OF BENEFICIAL USE MAP

UNDER

Application No. R-84128 Permit No. R-12824

IN NAME OF

MOMTAZI FAMILY, LLC

Surveyed July, 2015

TL 1100

Note: This map is not  
intended to provide legal  
dimensions or locations of  
property ownership lines.