

IMPORTANT
This Map for Assessment
and Taxation Purposes
ONLY


SEC. 2 T7S R5W WM
POLK COUNTY

Scale 1" = 400' 800'

Ely N.E. Corner
Claim No. 98
See Map 6.5.35

7.5.2

Received
MAY 27 2025
OWRD

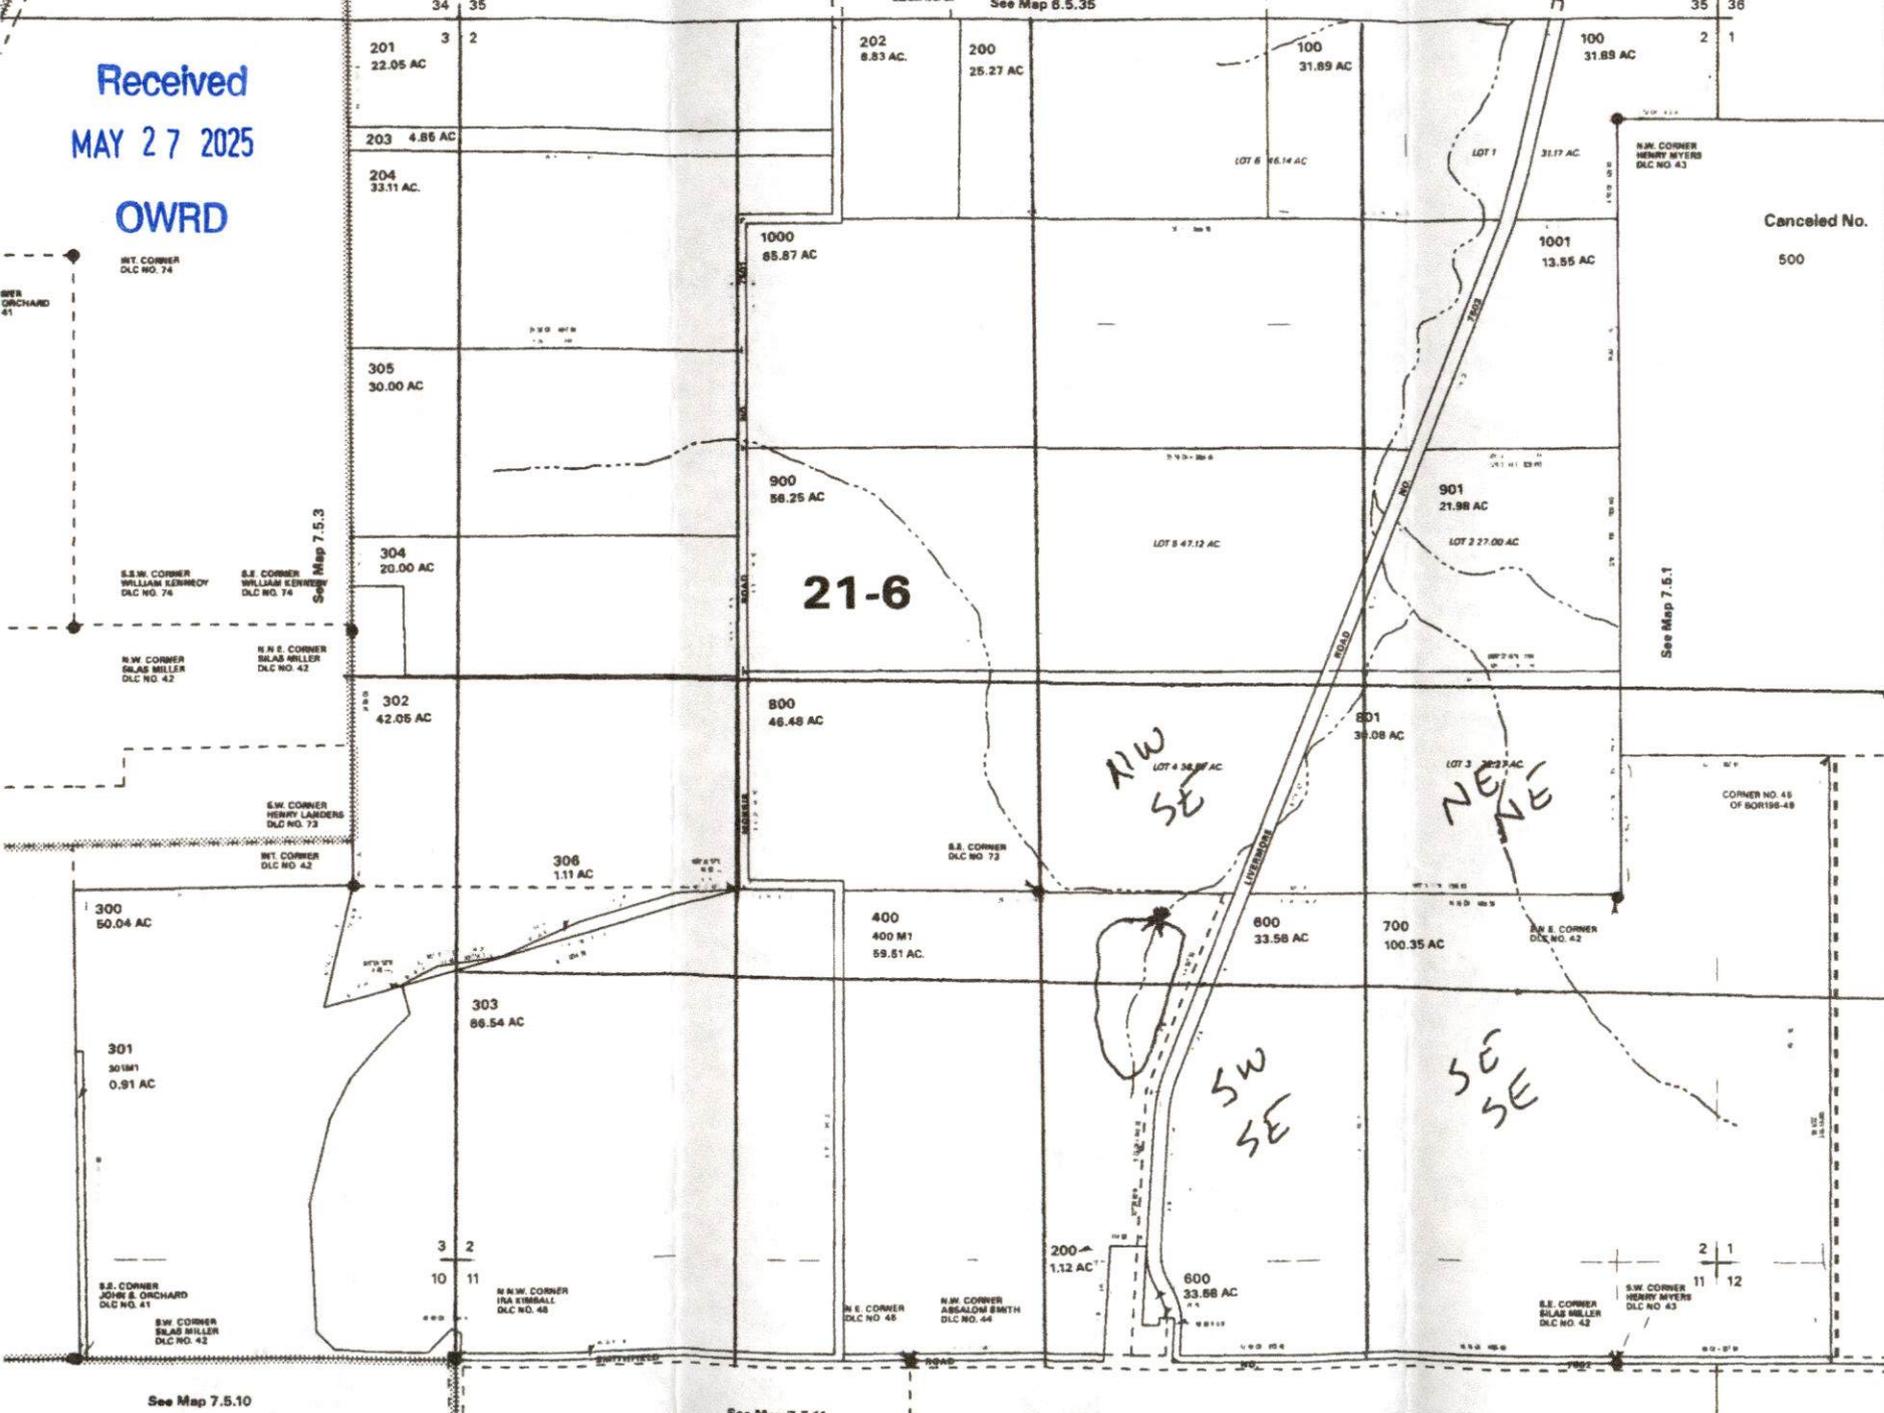

Canceled No.
500

DAMN / SPILLWAY LOCATED APPROX. 1400' N, 3000' E FROM
SW CORNER OF SECTION 2
R-08109

See Map 7.5.10

See Map 7.5.11