

OWRD


MAP FOR CLAIM OF BENEFICIAL USE FOR
DAVID BERNERT

ALL WITHIN THE R.V. SHORT DLC 46 AND N.W.BAILEY DLC 45
LOCATED IN THE NW $\frac{1}{4}$ AND NE $\frac{1}{4}$ OF THE NW $\frac{1}{4}$ OF SEC. 23, T3S,
R1W, W.M.

CLACKAMAS COUNTY

APPLICATION S-88429 PERMIT S-55123

NORTH

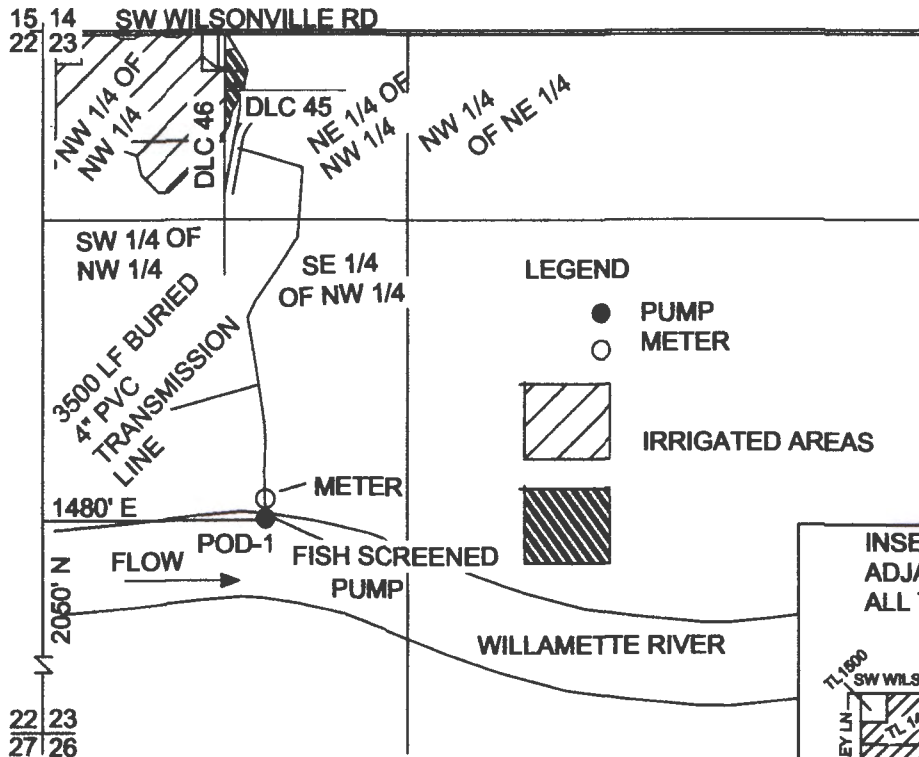

LEGEND

- PUMP
- METER



IRRIGATED AREAS





AREAS IRRIGATED:



NW 1/4 OF NW 1/4 & DLC 46 - 23.0 ACRES



NE 1/4 OF NW 1/4 - 1.33 ACRES INCLUDING
0.05 ACRES IN DLC 45

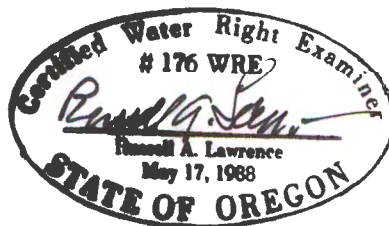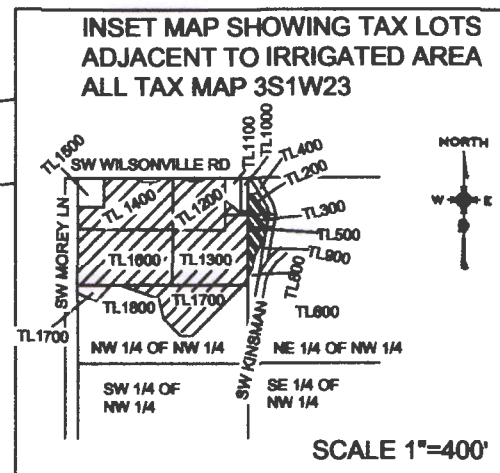

STREAM FIX

19478 STARVIEW LANE
OREGON CITY, OR 97045
(503) 781-4885

THIS MAP IS NOT INTENDED TO PROVIDE
LEGAL DIMENSIONS OF LOCATIONS OF
PROPERTY OWNERSHIP LINES.