


T10S R1E, WM
LINN COUNTY, OREGON

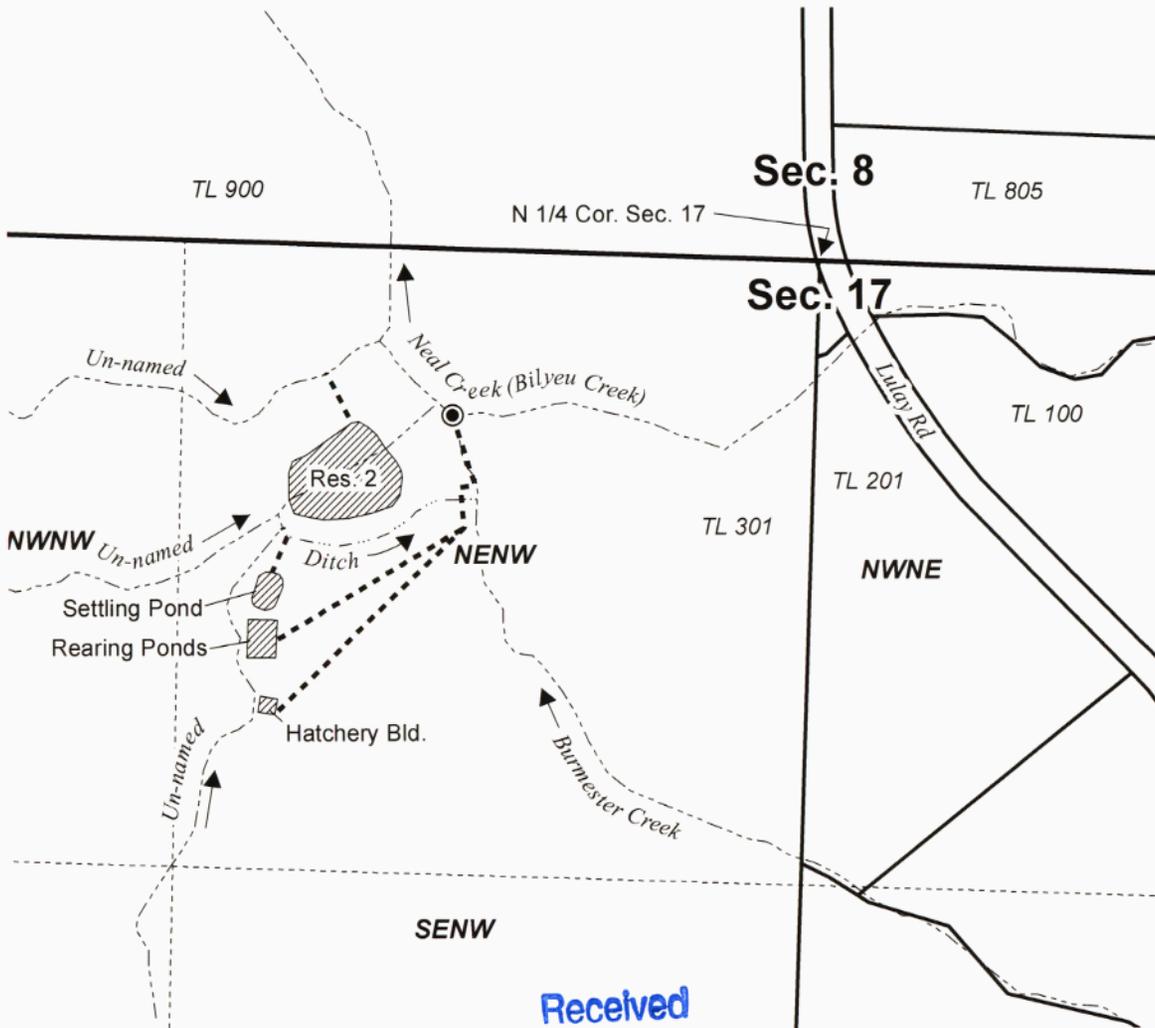

0 400 Feet
 1" = 400'



● POD, Pump, Meter, & Fishscreen

----- Pipeline

----- Ditch

----- Creek

▨ Commercial Use (Fish Hatchery)

— Section

----- Quarter Quarter

□ Tax Lot

POD Location:
 320' S, 770' W of N 1/4 Cor Sec 17



RENEWS: 06/30/2026



Received
 JUN 23 2025
 OWRD

CLAIM OF BENEFICIAL USE MAP
Blue Den Ranch, LLC

Date: 4/17/2025

AP S-85965 Permit S-54124

This map is not intended to provide legal dimensions or locations of property ownership lines.

WATER RIGHT SERVICES, LLC
 PO BOX 1830, BEND, OR 97709
 WWW.OREGONWATER.US CCB # 197121
 johnshort@usa.com 541-389-2837