



Sections 31 & 32, T12S, R5W, W.M., Benton County, Oregon

APPLICATION S-89319, Permit S-55462
Claim of Beneficial Use Map
O.O. Agriculture, LLC.

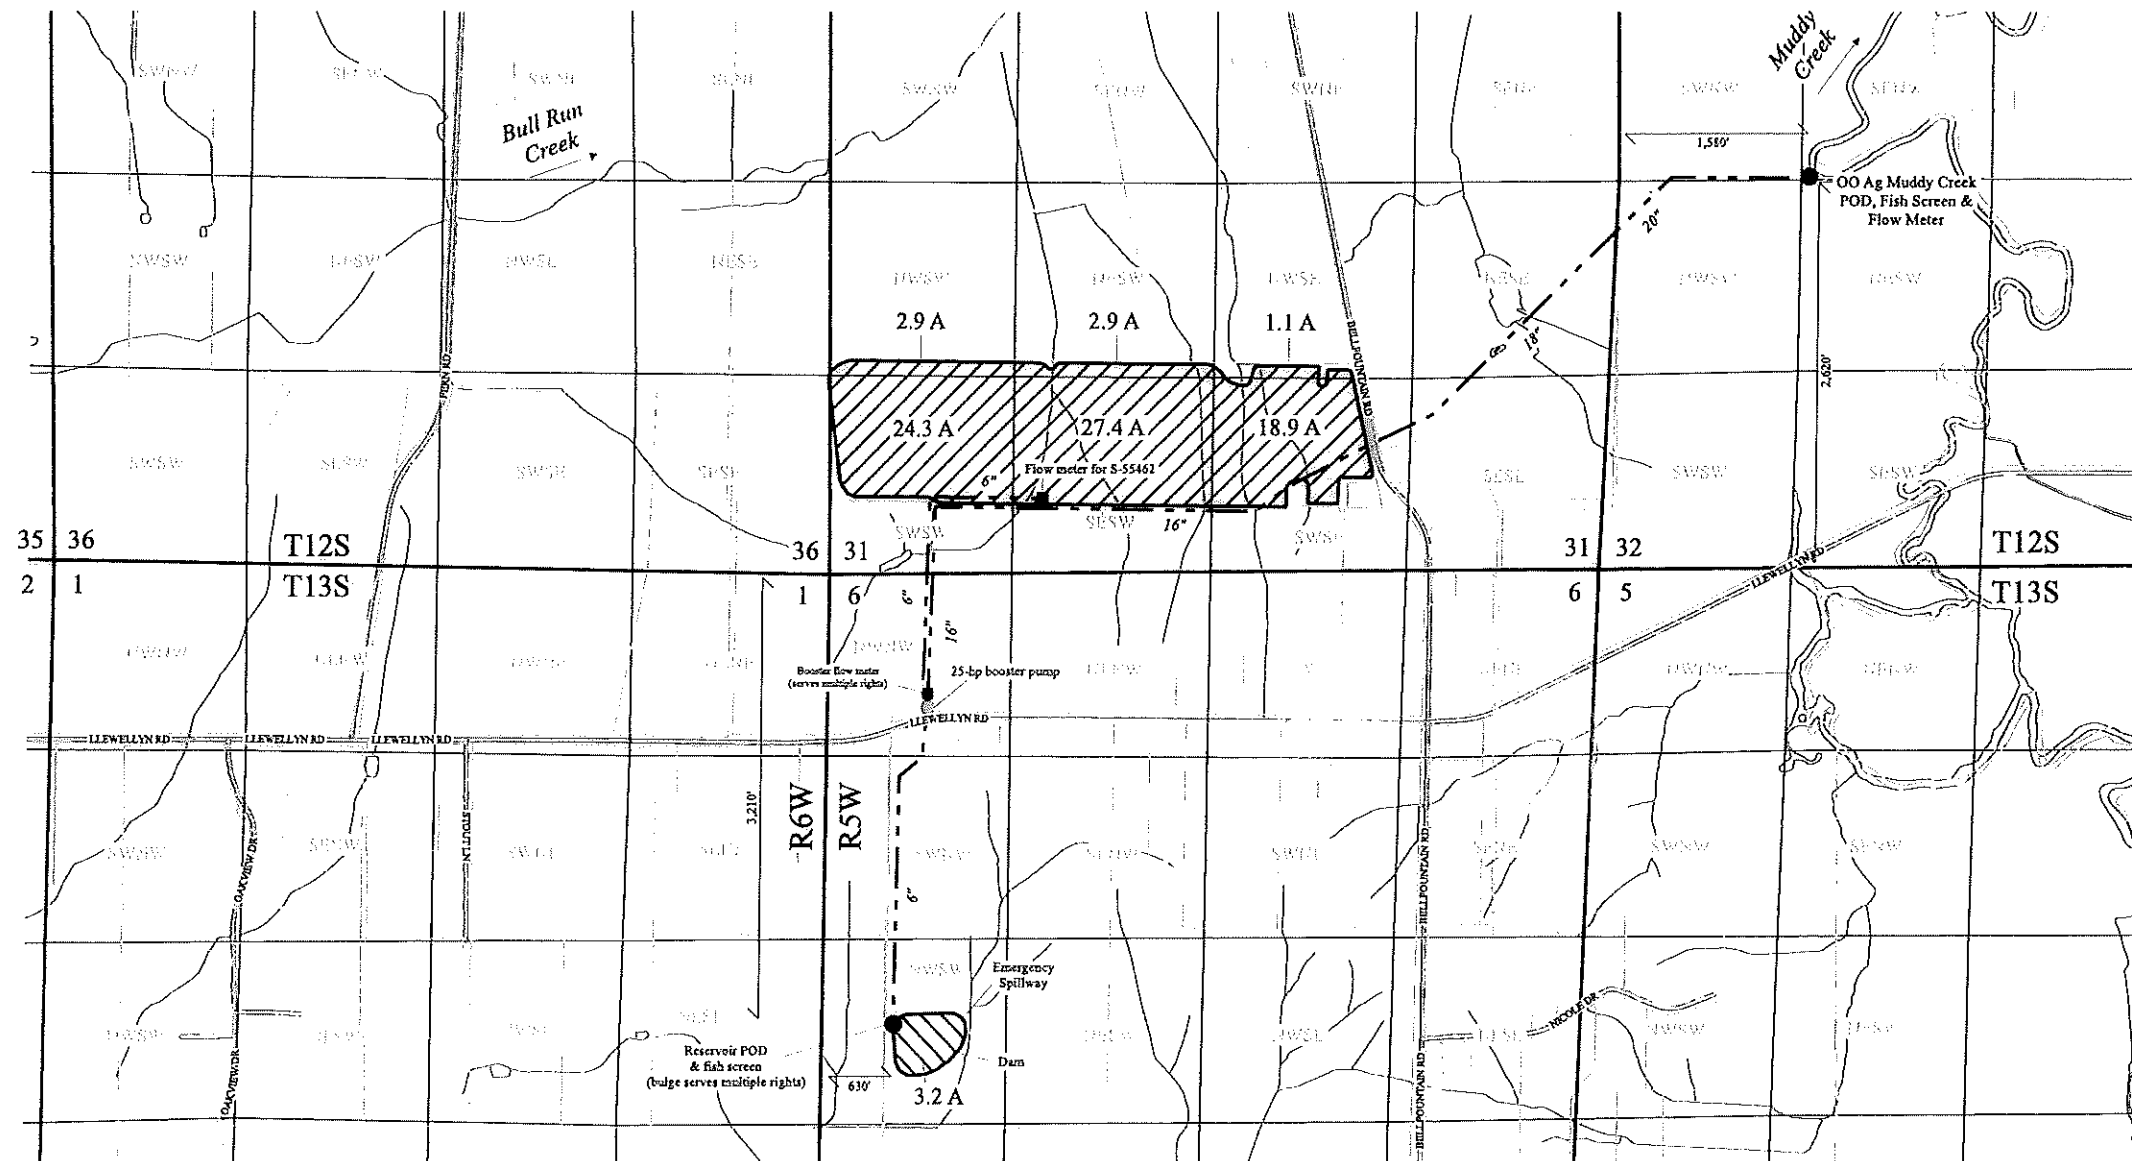

GREENBERRY ID POD AREA DETAIL T13S, R4W & R5W, W.M.

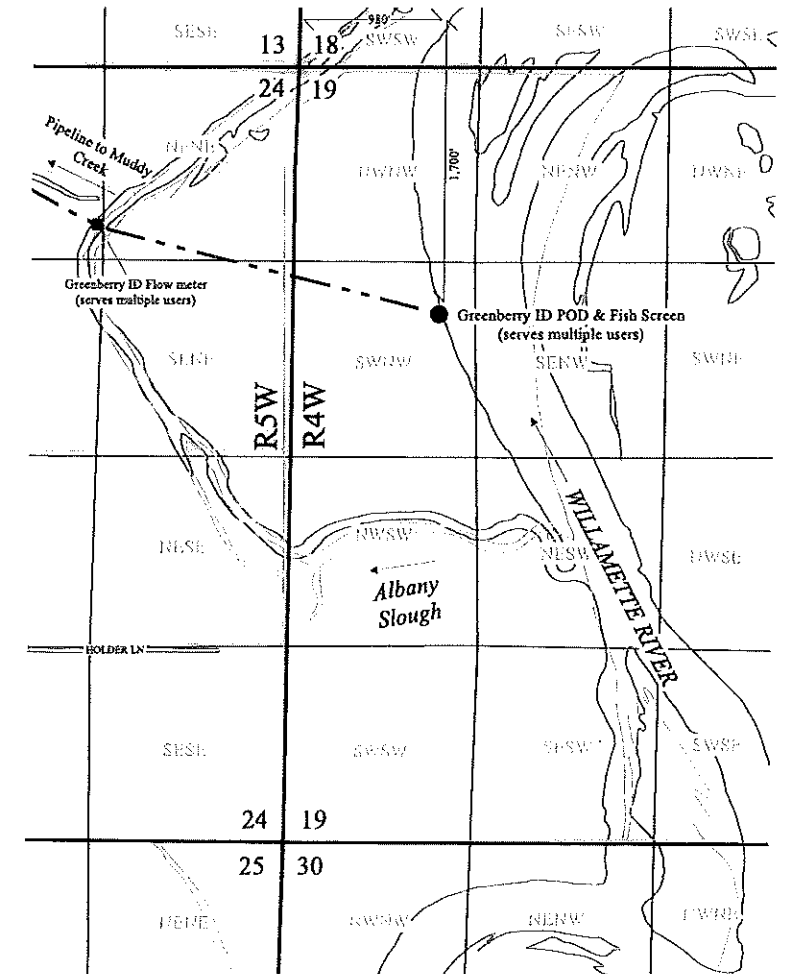

EXPLANATION

- Irrigation POU 77.5 Acres
- Reservoir 3.2 Acres Submerged
- Section
- Qtr Qtr
- Taxlots
- Roads
- Pipeline
- DLC
- Streams
- POD
- Flow Meter
- Booster



0 660 1,320 ft



1 INCH = 1,320 FEET

EnviroLogic Resources, Inc.
ENVIRONMENTAL WATER RESOURCES SCIENTISTS

NAD 1983 HARN
Datum of 1983
Prepared June 20, 2025

Sources: BLM CadNSD1 PLSS, roads, county lines & tax lots (Benton County & Corvallis GIS Data Center), Oregon Spatial Data Library water features, DLC lines, et al. Locations of proposed wells and points of use provided by client.

This map was prepared for the purpose of identifying the location of a water right only and is not intended to provide legal dimensions or locations of property ownership lines.

