


T.4S., R.1W., W.M.

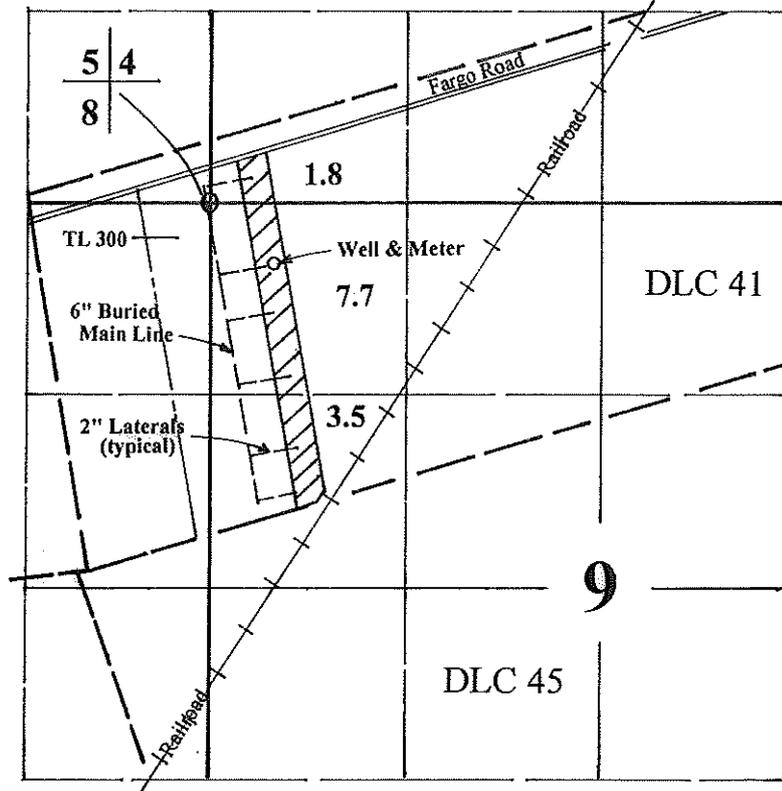

Well is located 440' S & 450' E from the NW corner of Section 9.

Claim of Beneficial Use


In the Name of

Schiedel Nursery

Application #: G-15458 Permit #: G-15228

Surveyed on June 27, 2016 by JM Schuette

This Map was Prepared for the Purpose of Identifying the Location of a Water Right Only and is Not Intended to Provide Legal Dimensions or Location of Property Ownership Lines.

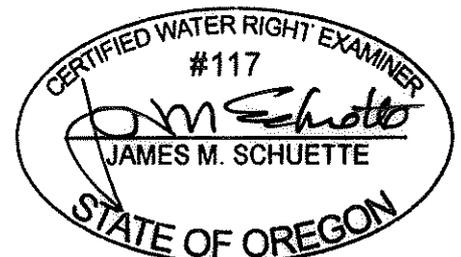

EXPIRES: 6-30-18