



**T23S, R32.5 E,  
SECTION 13, WM**

HARNEY COUNTY, OREGON

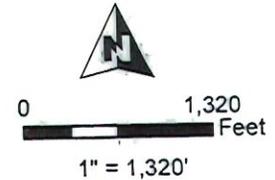

-  POU Irrigation
-  Township
-  Section
-  Quarter Quarter
-  Taxlot

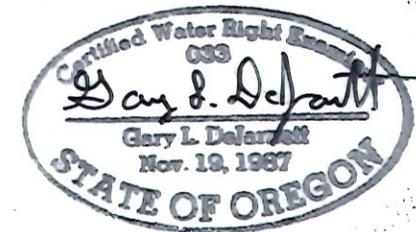

RENEWAL DATE 12/31/2015

11

12

TL 500 TL 300 TL 200 TL 100  
TL 400

07

TL 600 TL 700 TL 800 TL 900

14

13

TL 1200 TL 1000

NWSW

NESW

40 AC

T23S R32.5E

T23S R33E

18

SWSW

SESW

40 AC

23

WELL & METER:  
60' N, 1020' E OF  
SW COR SEC 13

24

RECEIVED BY OWRD

MAR 03 2015

SALEM, OR

19

**CLAIM OF BENEFICIAL USE MAP**  
Edwin Ensz

NOTE: THIS MAP IS NOT INTENDED TO  
PROVIDE LEGAL DIMENSIONS OR LOCATIONS  
OF PROPERTY OWNERSHIP LINES.

**WATER RIGHT SERVICES, LLC**  
PO BOX 1830, BEND, OR 97709  
CCB# 197121 [www.oregonwater.us](http://www.oregonwater.us)  
541-389-2837 [JOHNSHORT@USA.COM](mailto:JOHNSHORT@USA.COM)

AP G-17641

PERMIT G-17153

PROJECT #14096

JANUARY 12, 2015