


Application G-17788, Permit G-17465
 Claim of Beneficial Use
 Thomas E. & Karen M. Avinelis (Quiet Meadows Farm)

WILL MCGILL
SURVEYING LLC
 15333 Pletzer Rd. SE
 Turner, OR 97392
 503-510-3026
 willmcgill.surveying@gmail.com

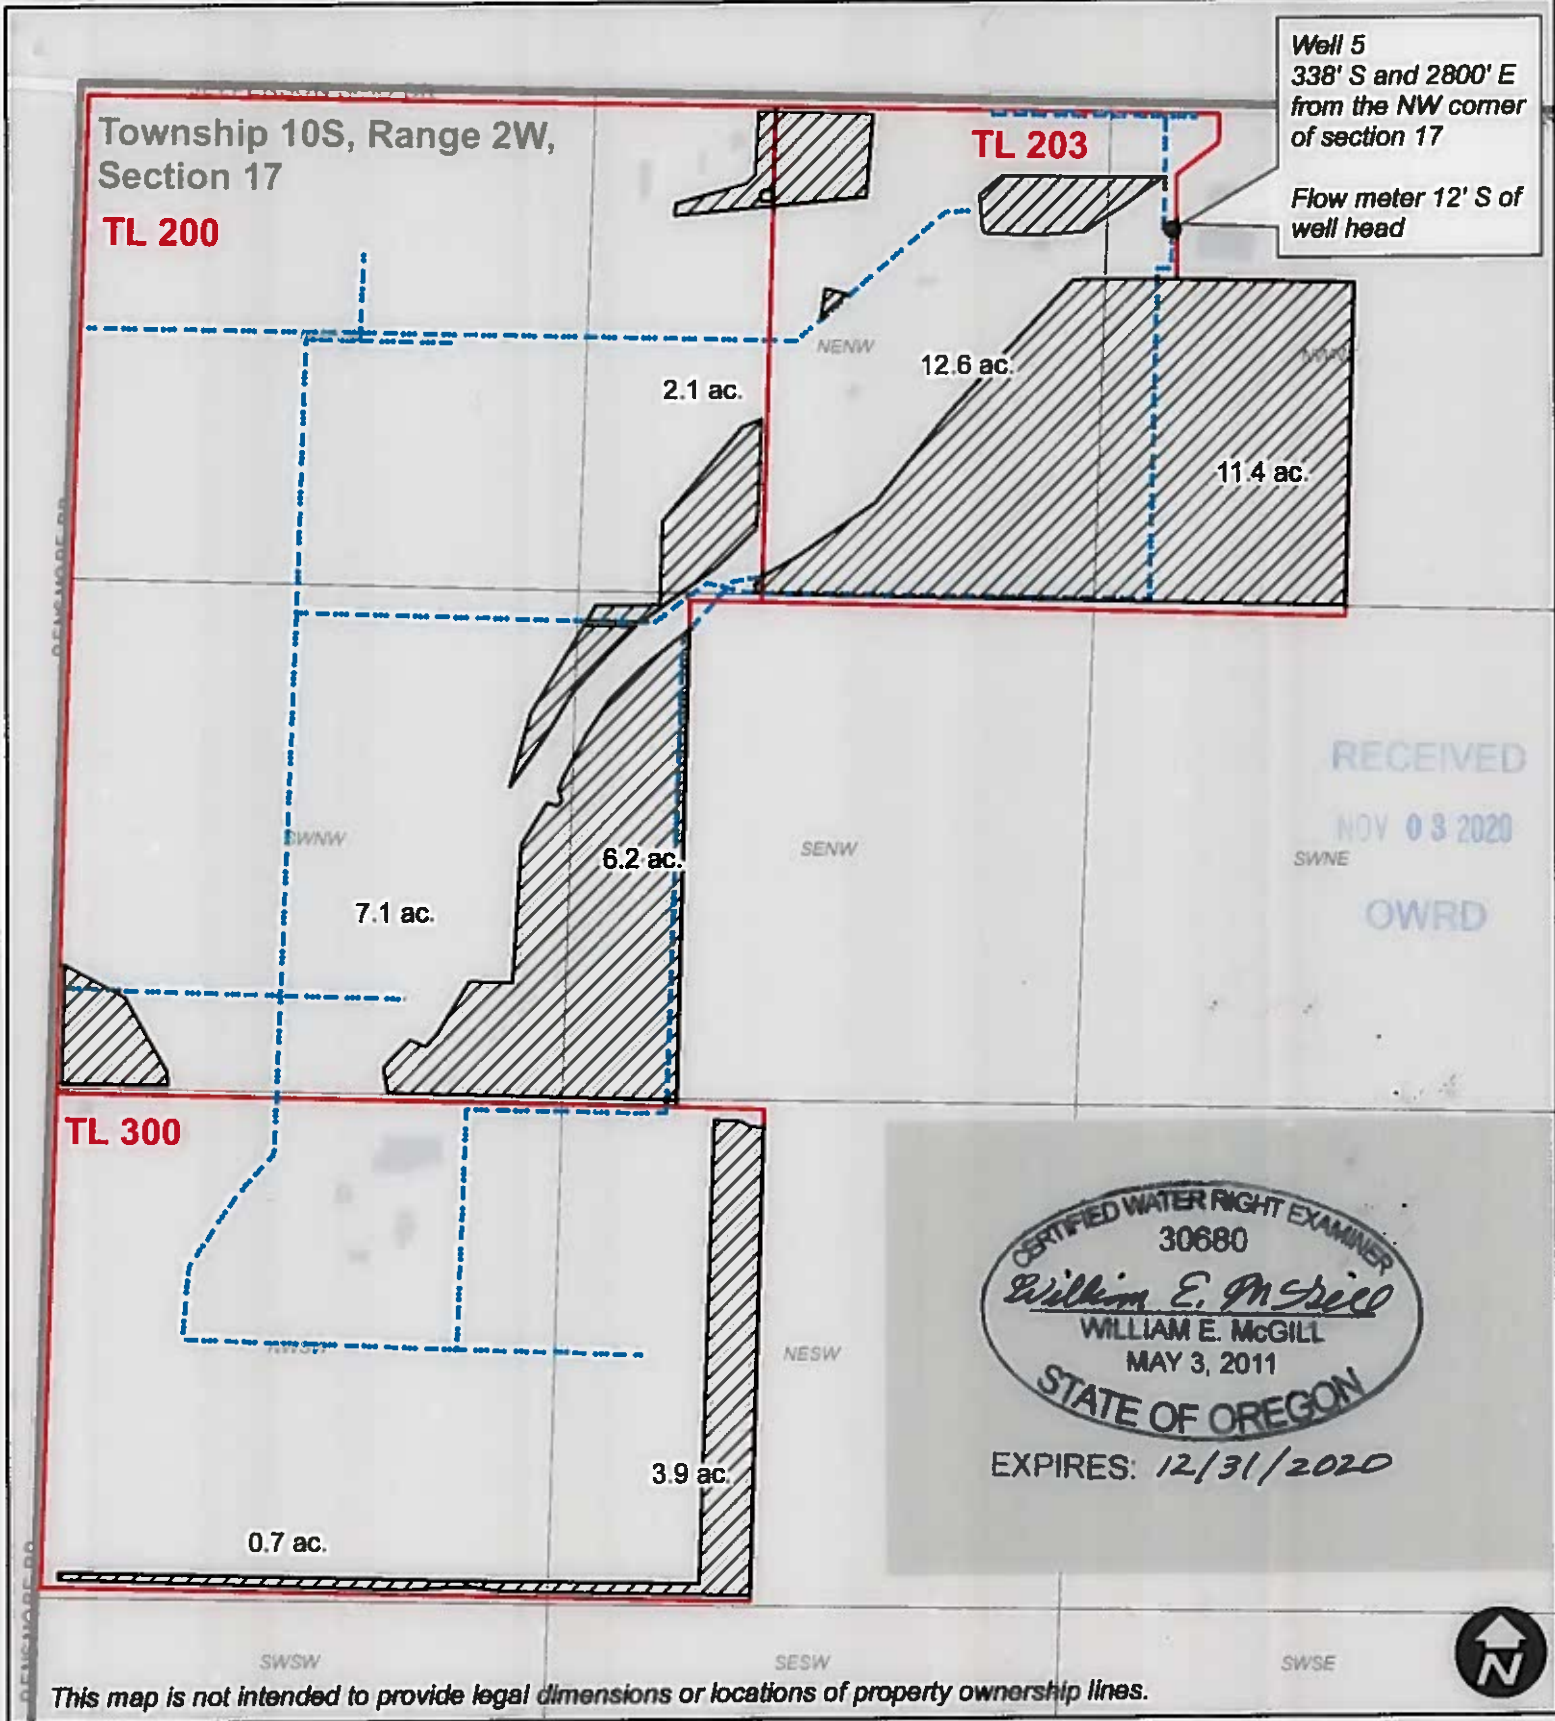

This map is not intended to provide legal dimensions or locations of property ownership lines.

Legend Place of Use Mainline Tax Lot