


T.3S. R.2W. Section 22, W.M.

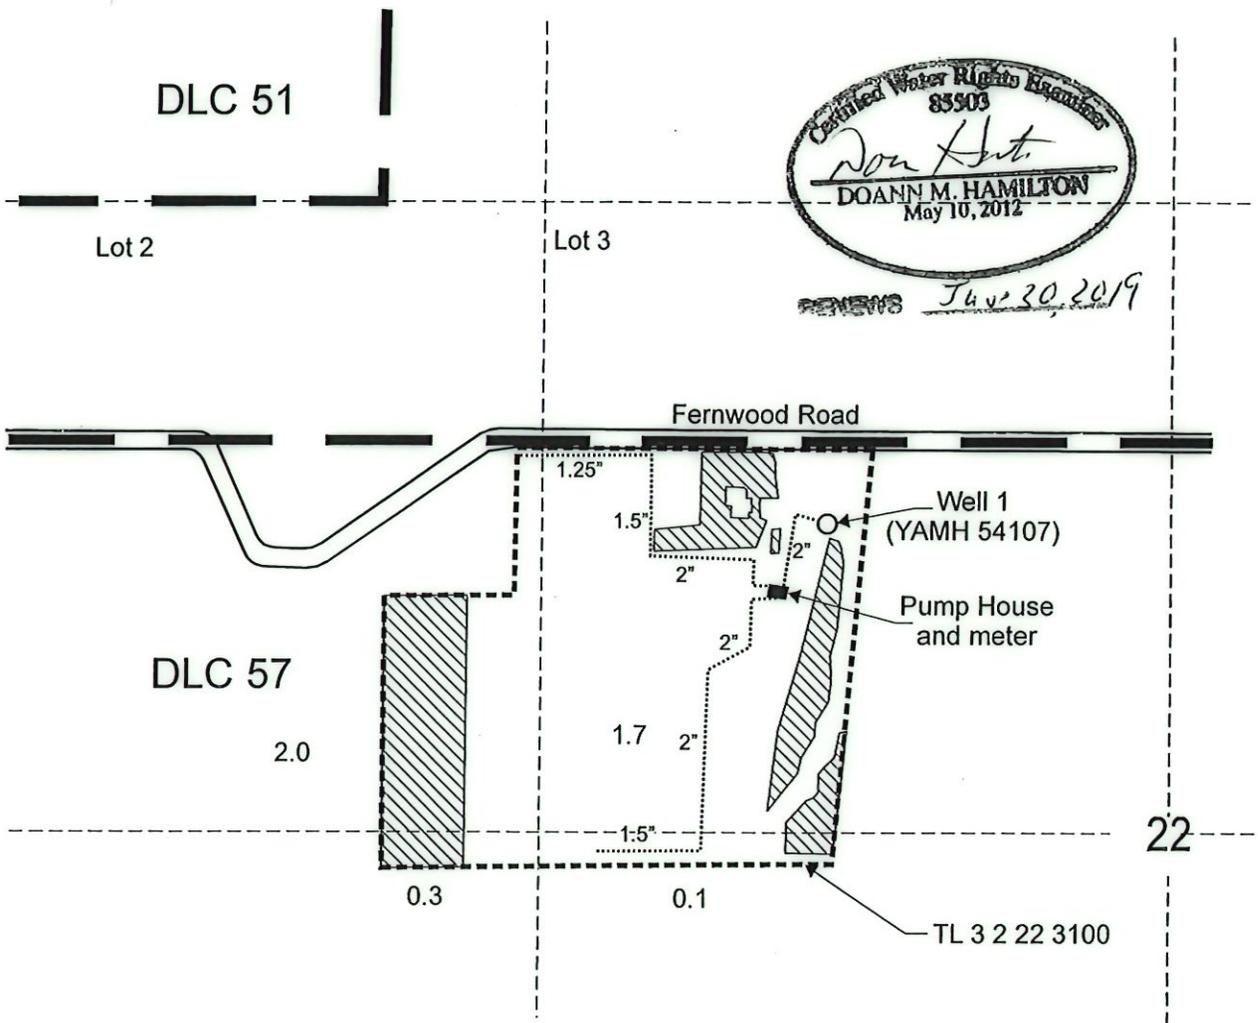

RENEWS June 30, 2019

Well 1 is located 650 feet south and 970 feet east from the SE corner, DLC 51.

 Area (4.1 acres) irrigated under Application G-18089, Permit G-17553.

 Tax lot boundary

 Donation Land Claim

 Irrigation mainline, buried

RECEIVED

NOV 17 2017

OWRD

Scale: 1" = 400'



This map was prepared for the purpose of identifying the location of a water right only and is not intended to provide legal dimensions or location of property ownership lines.

Claim of Beneficial Use Map
Application G-18089, Permit G-17553

James Dennis Pierce
T.3S. R.2W. Section 22, W.M.

Pacific Hydro-Geology Inc.

09/2017