

FINAL PROOF MAP



TO ADD A POINT OF APPROPRIATION
FOR T-8540
JAMES & SUE GILMOUR

TOWNSHIP 27 SOUTH, RANGE 34 EAST, SECTION 5, W.M.
TAX LOT: 601

RECEIVED BY OWRD

DEC 05 2012

SALEM, OR

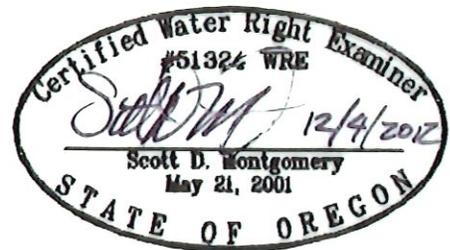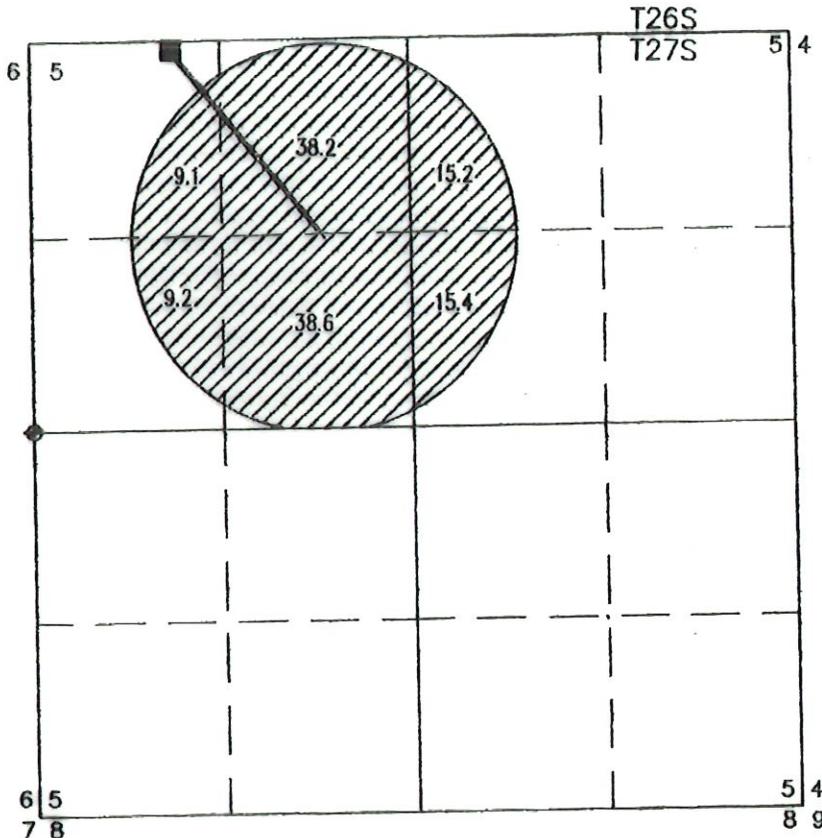

RENEWAL DATE: 12/31/2012

WELL 2 (HARN 50318)

LOCATED IN THE NW 1/4 NW 1/4 SECTION 5, T27S R34E, W.M. AND 35 FEET SOUTH AND 975 FEET EAST FROM THE NW CORNER OF SECTION 5.

NEWLY INSTALLED METER IS APPROXIMATELY 6.5 FEET SOUTHEAST ALONG DELIVERY PIPE FROM WELL.

◆ 3-1/2" ALUMINUM CAPPED SECTION MONUMENT



125.7 ACRES WATER RIGHTS FROM PERMIT G-11338, TRANSFERRED FROM HARN 1489 TO HARN 50318, AS SHOWN.

THIS MAP IS FOR THE PURPOSE OF LOCATING A WATER RIGHT ONLY AND HAS NO INTENT TO PROVIDE LEGAL DIMENSIONS OR THE LOCATION OF PROPERTY LINES

<p>PREPARED FOR:</p> <p>JAMES & SUE GILMOUR 30427 STELLMACHER DRIVE ALBANY, OR 97321</p>	<p>PREPARED BY:</p> <p>ALL POINTS ENGINEERING AND SURVEYING, INC. P.O. BOX 767 (CRR) TERREBONNE, OR 97760 (541) 548-5833 www.APEandS.com</p>
--	--