




T.3S. R.1W. Section 25, W.M.

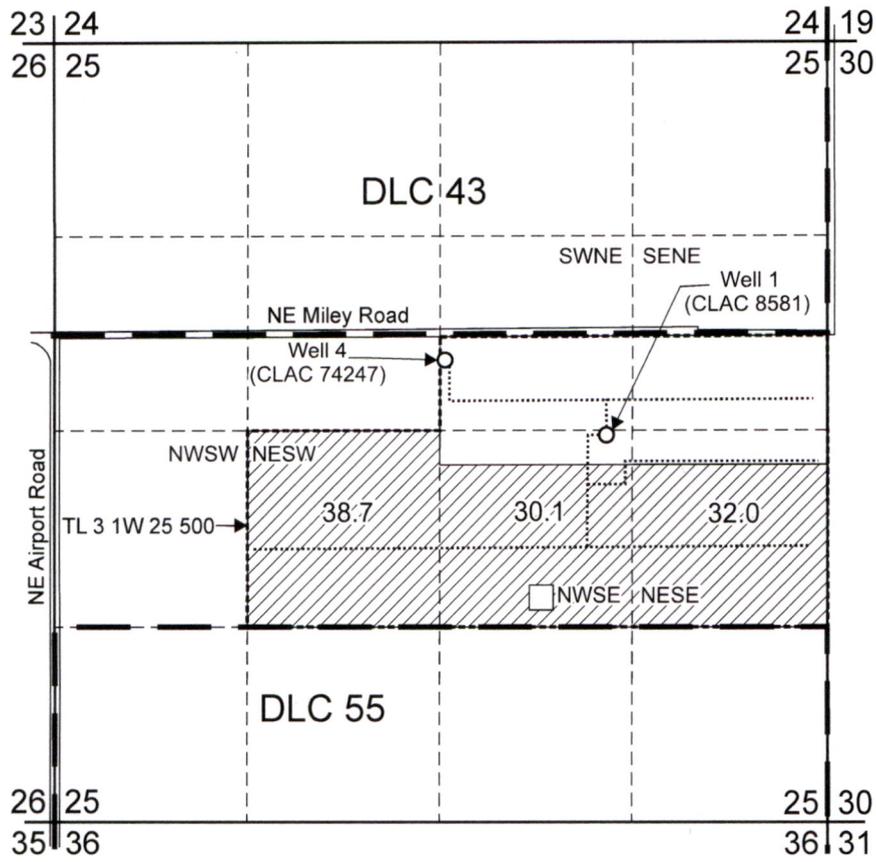

Received
JAN 02 2025
OWRD

Well 1 (CLAC 8581) is located 10 ½ chains south and 22 ¾ chains west from the SE corner, DLC 43.
Well 4 (CLAC 74247) is located 480 feet north and 2,610 feet west from the E ¼ corner, Section 25.

-  Area (100.8 Acres) irrigated under T-12560, formerly Certificate 38511, priority date: 4-12-1967.
-  Tax lot boundary
-  DLC boundary
-  Irrigation mainline

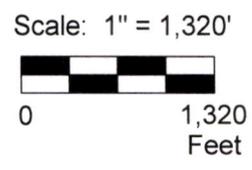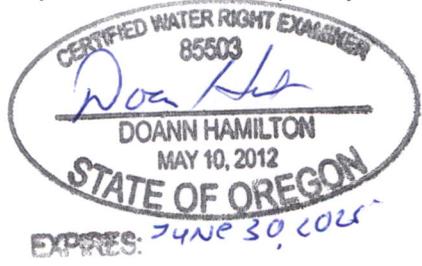

This map was prepared for the purpose of identifying the location of a water right only and is not intended to provide legal dimensions or location of property ownership lines.



Claim of Beneficial Use Map T-12560, formerly Certificate 38511

Pacific Hydro-Geology Inc.

Oregon State University
North Willamette Research and Extension Center
T.3S. R.1W. Section 25, W.M.

11/2024

OSUT-12560Cert38511COBUMap.cdr