


**T24S R33E, WM,
HARNEY COUNTY, OR**



0 400
Feet

1" = 400'

- Well & Meter
- Pipeline
-  POU Commercial Use
-  Township
-  Section
- Quarter Quarter
-  Tax Lot
- Quarter Quarter

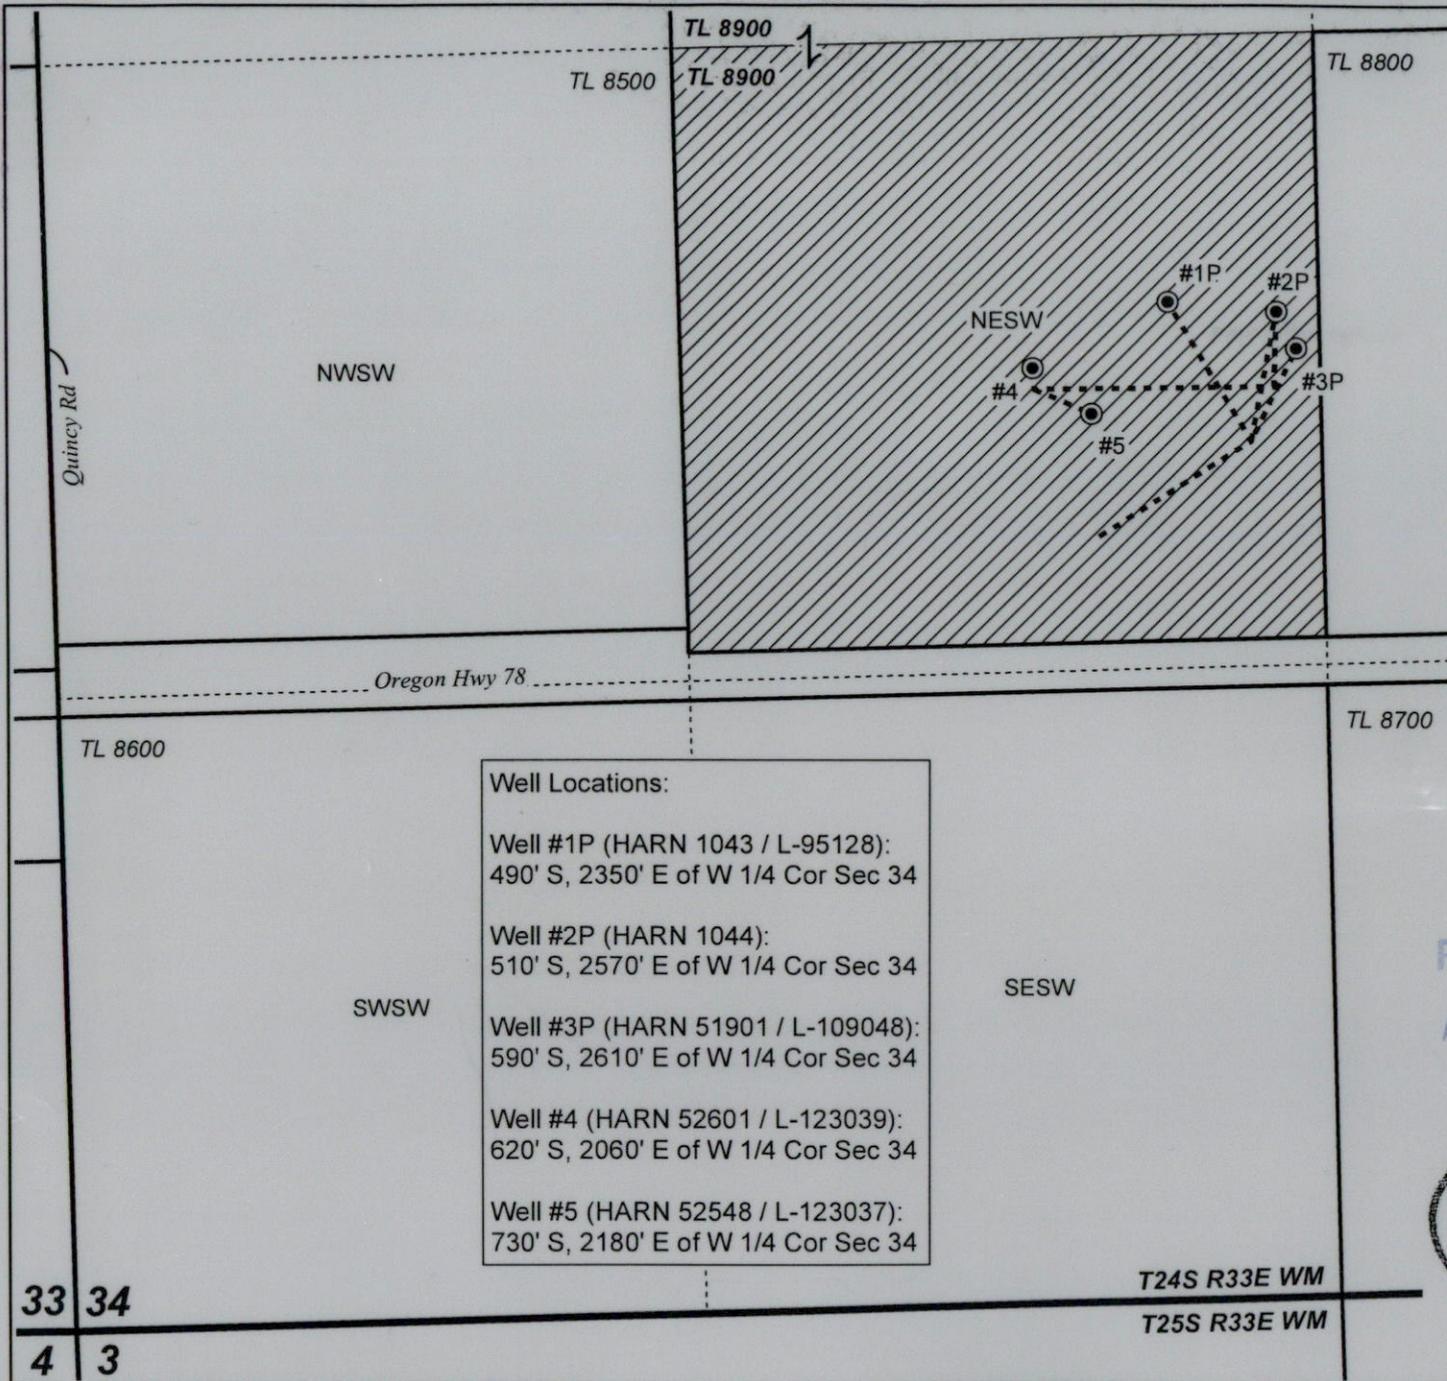

Well Locations:

Well #1P (HARN 1043 / L-95128):
490' S, 2350' E of W 1/4 Cor Sec 34


Well #2P (HARN 1044):
510' S, 2570' E of W 1/4 Cor Sec 34

Well #3P (HARN 51901 / L-109048):
590' S, 2610' E of W 1/4 Cor Sec 34

Well #4 (HARN 52601 / L-123039):
620' S, 2060' E of W 1/4 Cor Sec 34

Well #5 (HARN 52548 / L-123037):
730' S, 2180' E of W 1/4 Cor Sec 34

RECEIVED RECEIVED
AUG 25 2021 JUL 23 2021
OWRD OWRD

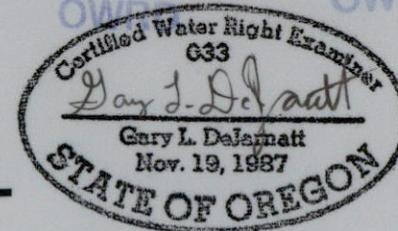

RENEWAL DATE 12/31/2021

33 34
4 3

T24S R33E WM
T25S R33E WM

**CLAIM OF BENEFICIAL USE MAP
DANIEL & DENISE KRYGER**

This map is not intended
to provide legal dimensions
or locations of property
ownership lines.

WATER RIGHT SERVICES, LLC
PO BOX 1830, BEND, OR 97709
WWW.OREGONWATER.US CCB # 197121
johnshort@usa.com 541-389-2837