


Township 34S, Range 6W

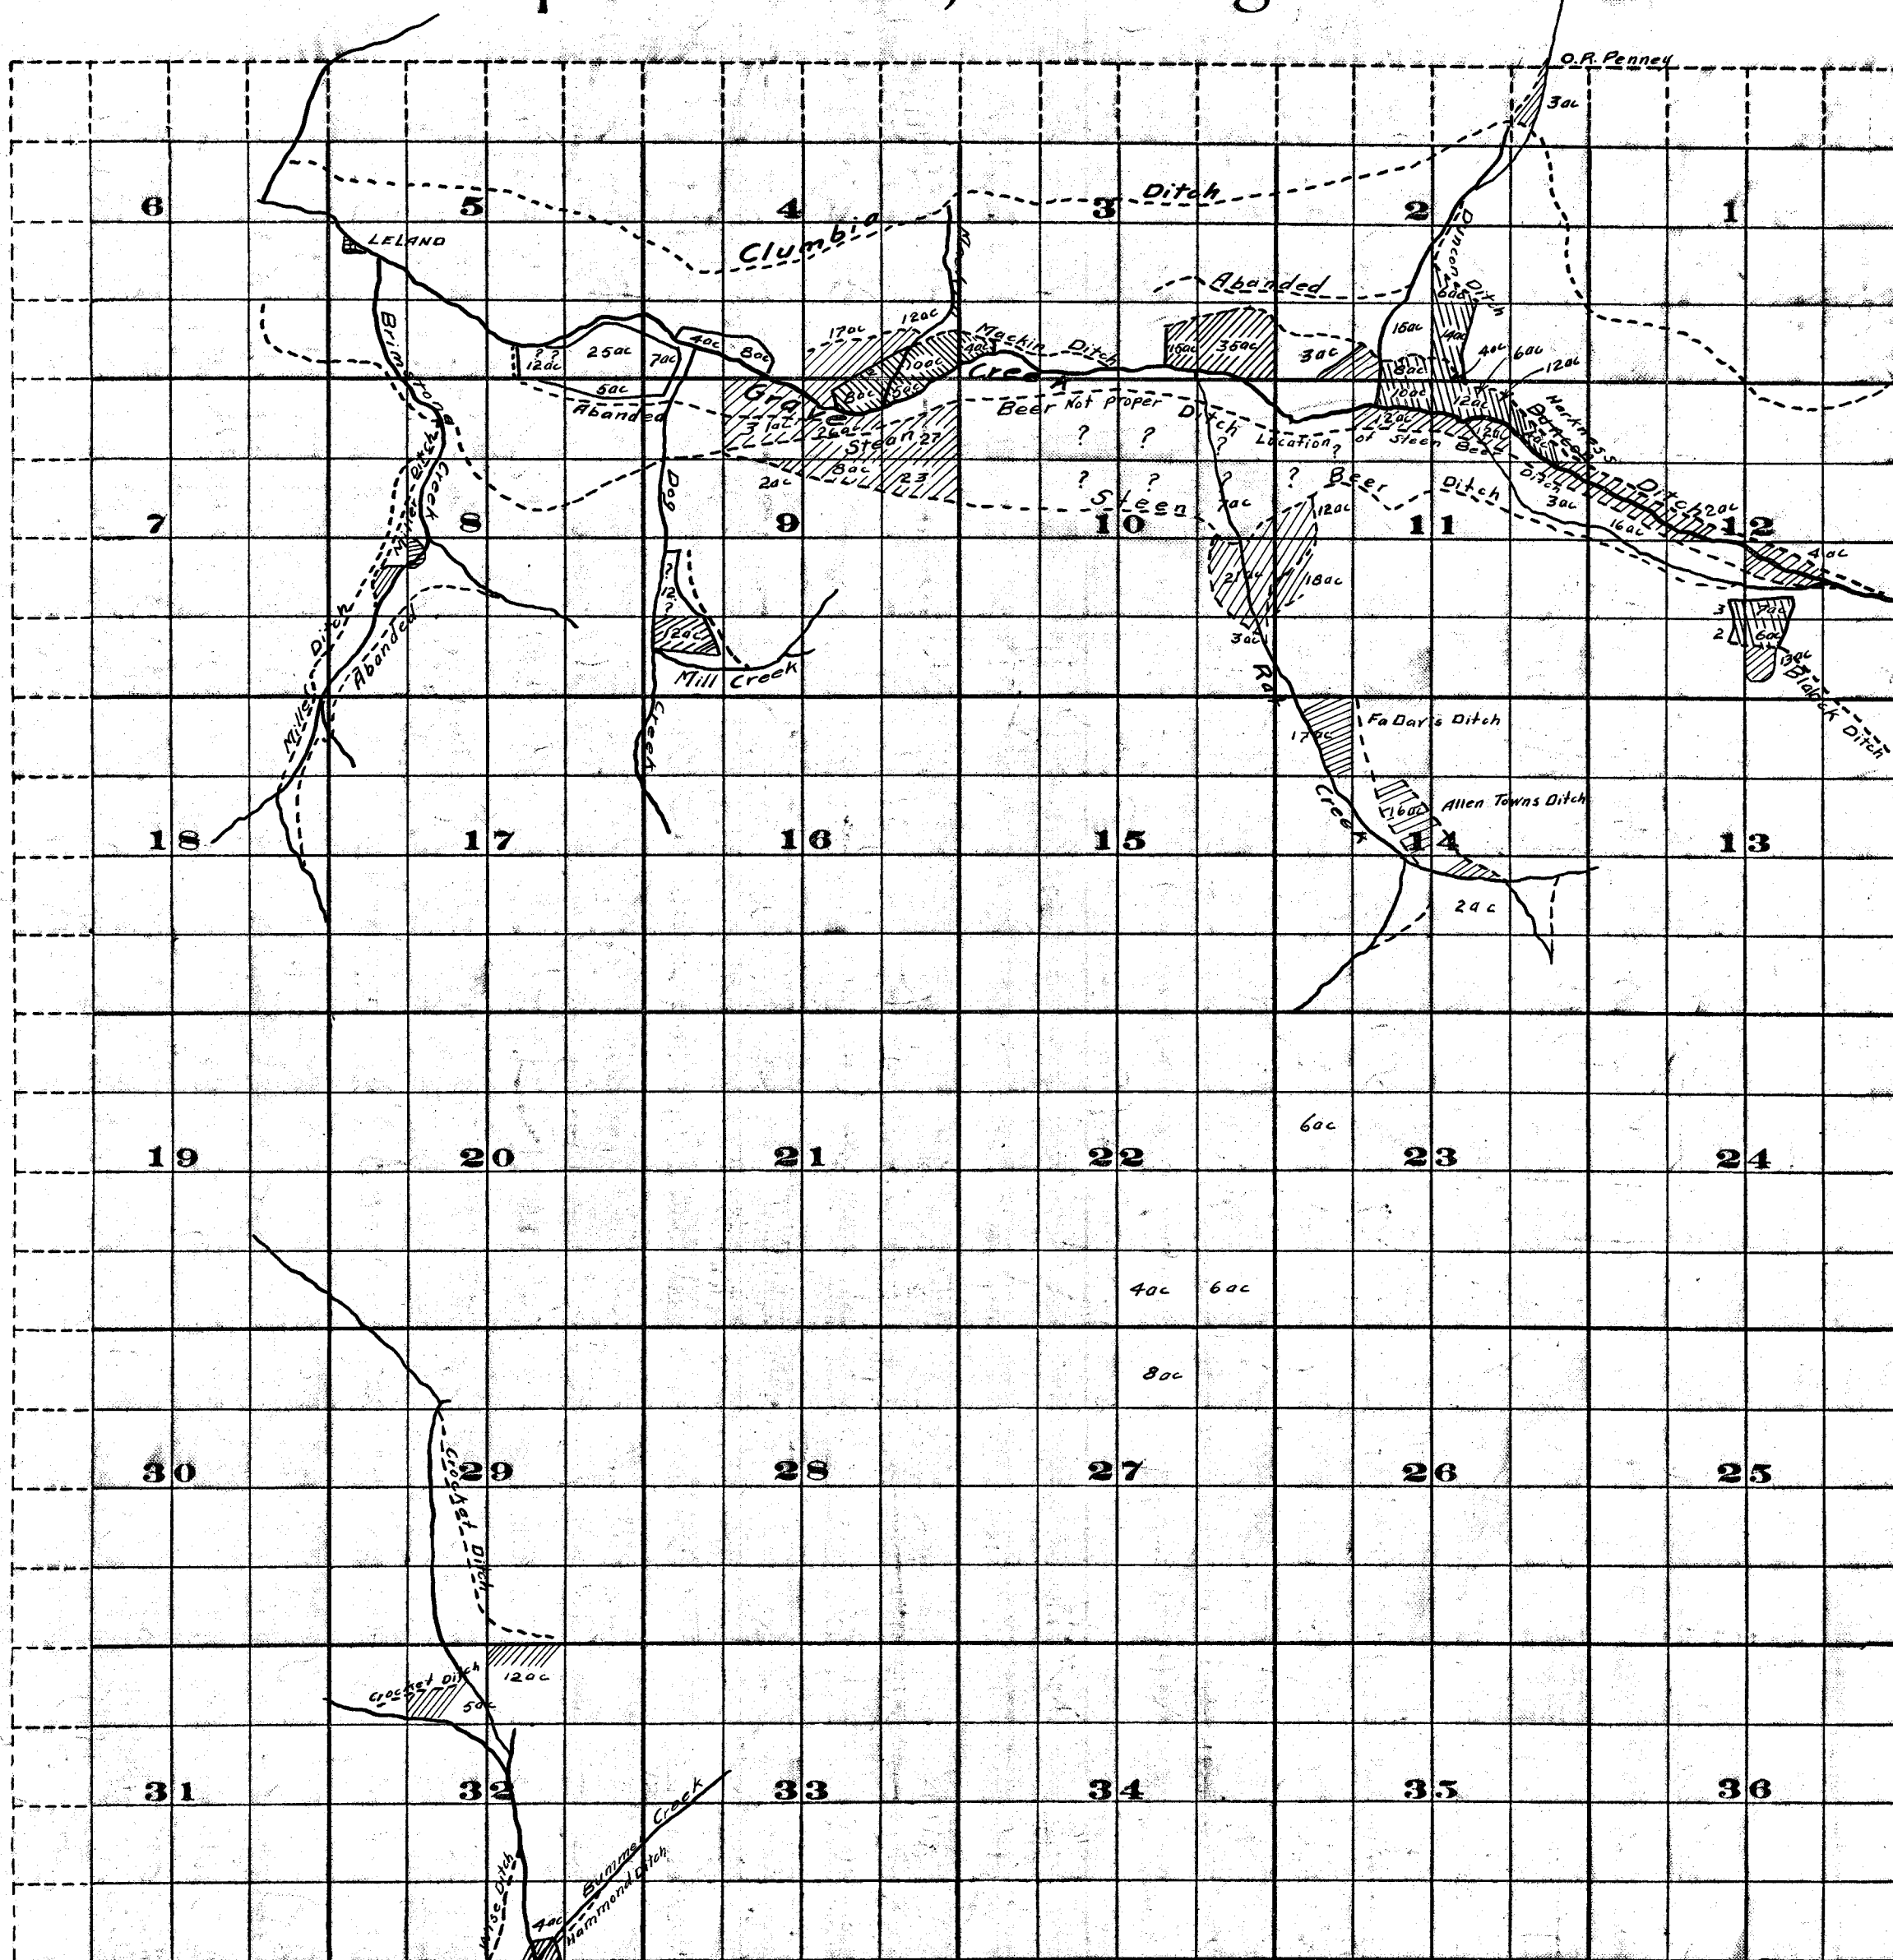

Survey by J.S. Mahan May 1910

FROM OFFICE OF THE STATE ENGINEER, SALEM, OREGON

M.D.
D.R.M. 47-11

Scale of Feet.

Ajudication

Rogue River and Tributaries

John H. Lewis State Engr

Examined Sept. 18, 1911.