

FINAL PROOF SURVEY

UNDER

APPLICATION NO. 70439


PERMIT NO. 51213

IN THE NAME OF BURL JAMES OR JOSEPHINE M. EASTMAN

SURVEYED OCTOBER 23, 1991 BY J. EDWARD HENRICKS

SCALE 1"=1320'-0"

SECTION 10
T.10S.,R.2W.,W.M.
LINN COUNTY, OREGON

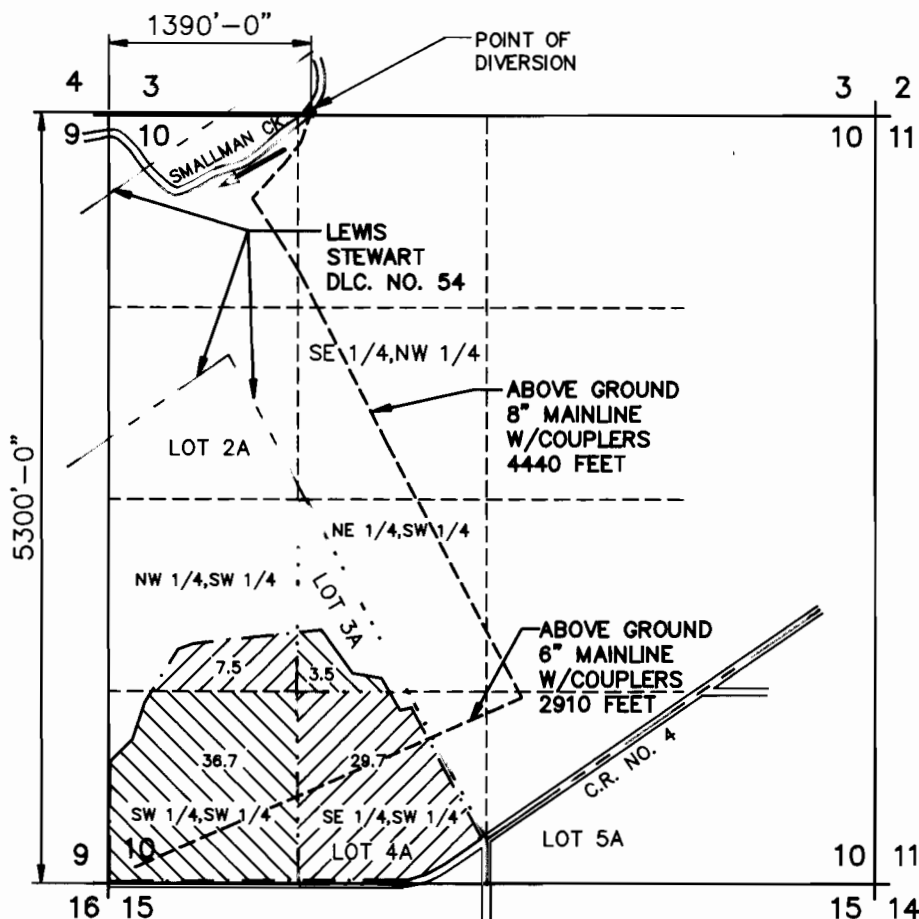

LEGEND:

- SECTION LINES
- FORTY LINES
- . - . - . PROPERTY LINE
- ABOVE GROUND MAINLINE
- - - - - DONATION LAND
- CLAIM LINE
- LOT LINE

ONLY DOCUMENTS STAMPED
WITH RED INK ARE ORIGINALS

I J. EDWARD HENRICKS, BEING DULY SWORN AS A WATER RIGHT EXAMINER
LICENSE NO. 170 HAVE PREPARED THIS MAP FOR BURL JAMES AND JOSEPHINE
M. EASTMAN ON THIS 23rd DAY OF OCTOBER, 1991. THE AREAS CROSS HATCHED
REPRESENT THE ACREAGES TO BE IRRIGATED BY THIS WATER RIGHT.

PREPARATION OF THIS MAP IS FOR THE PURPOSE OF IDENTIFYING
THE LOCATION OF THE WATER RIGHT ONLY AND HAS NO INTENT TO PROVIDE
DIMENSIONS OR LOCATION OF PROPERTY OWNERSHIP LINES.

J. Edward Henrichs