


T5N, R1W, Sec. 28

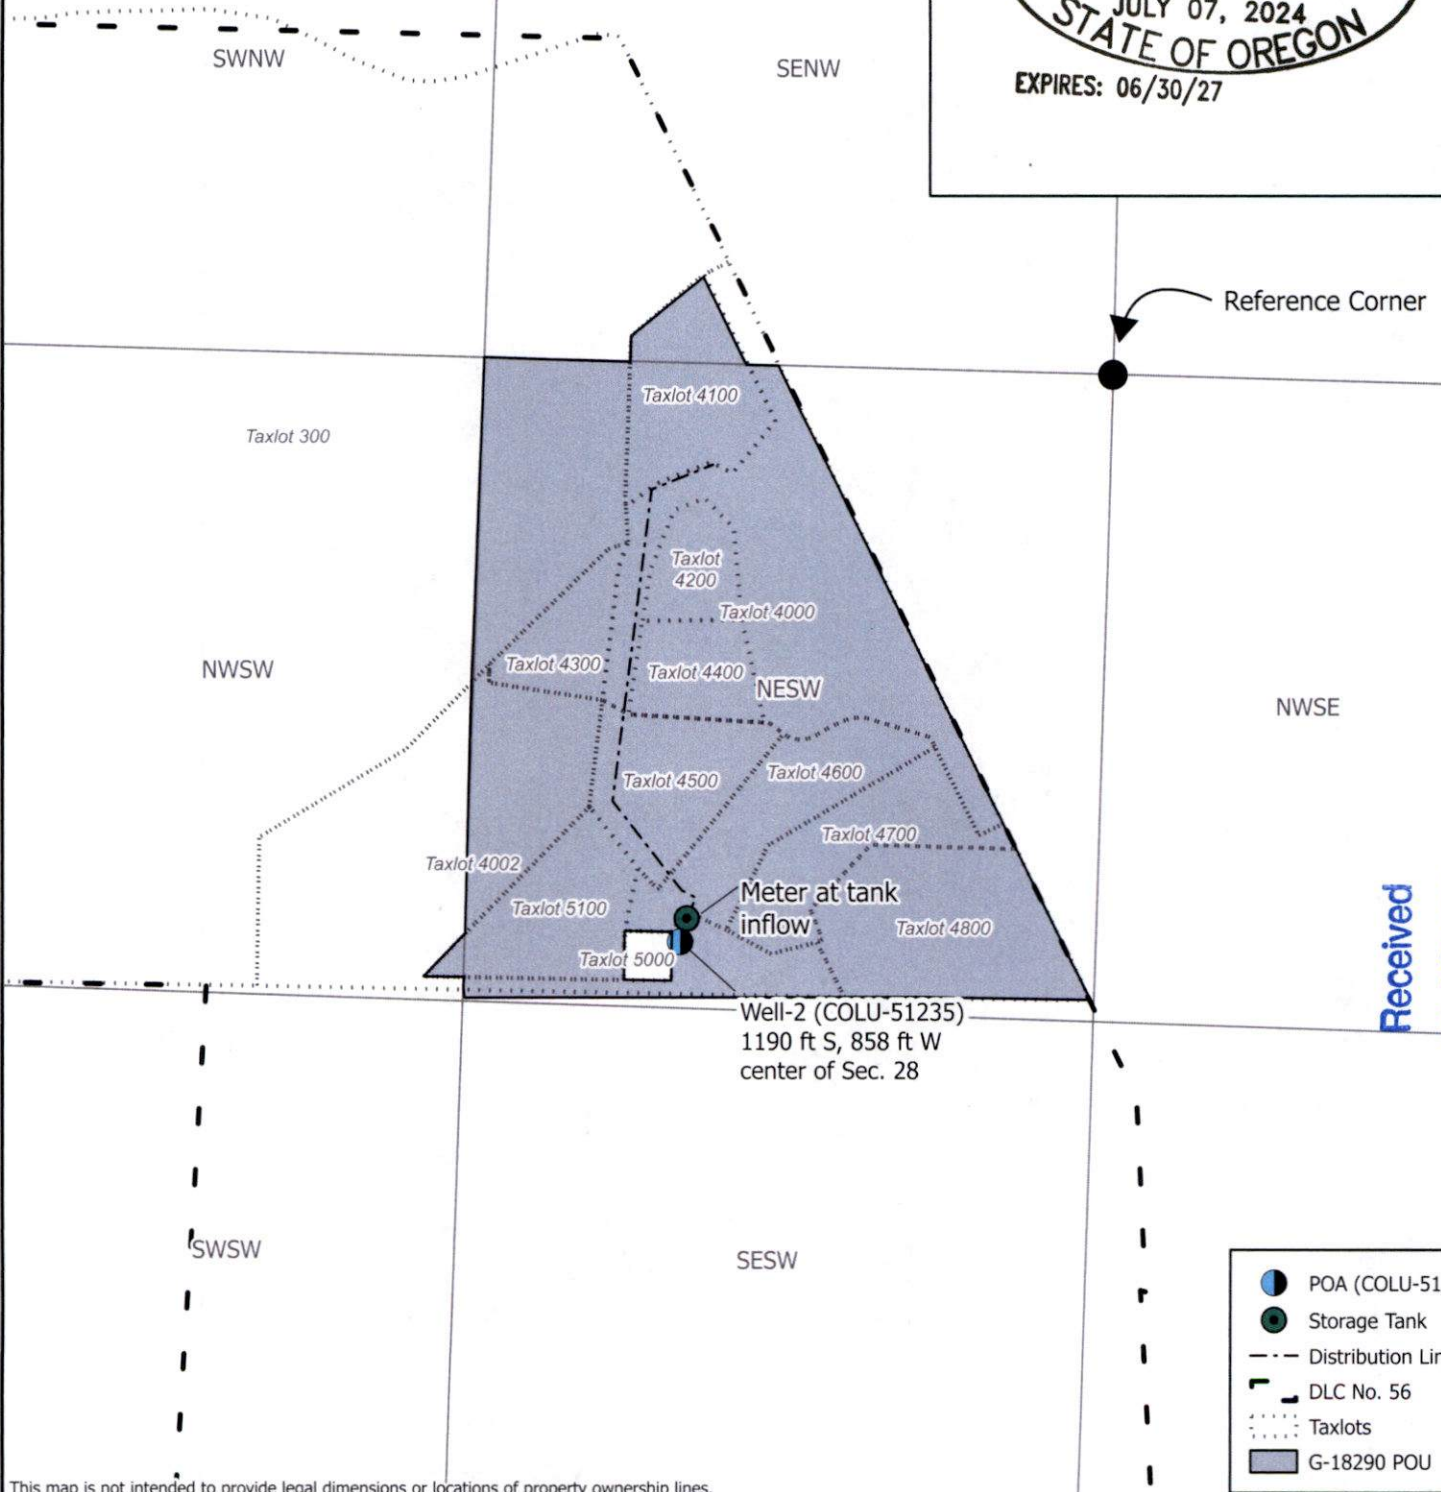

This map is not intended to provide legal dimensions or locations of property ownership lines.



311 B Avenue, Suite P
Lake Oswego, Oregon 97034
(503) 954-1326

COBU Map
Application G-18568
Permit G-18290

1	DATE	AUTH	DRAFT
No.	Date	By	Revisions



0 250 500 Feet
1:4,800

Proj#: 2427001
Miloris Water Association CBU
Miloris Water Association
PO Box 523
Columbia City, OR 97018