

T.11S. R.4W. Sec. 23, 24, 25, & 26, W.M.

CERTIFIED WATER RIGHT EXAMINER
 MAY 10, 2012
 STATE OF OREGON
 EXP. JUL 30, 2017

Harman
DLC 77


Hughes
DLC 78

NW corner
DLC 76

Lot 2 Lot 1

Watson
DLC 62

Simpson
DLC 76

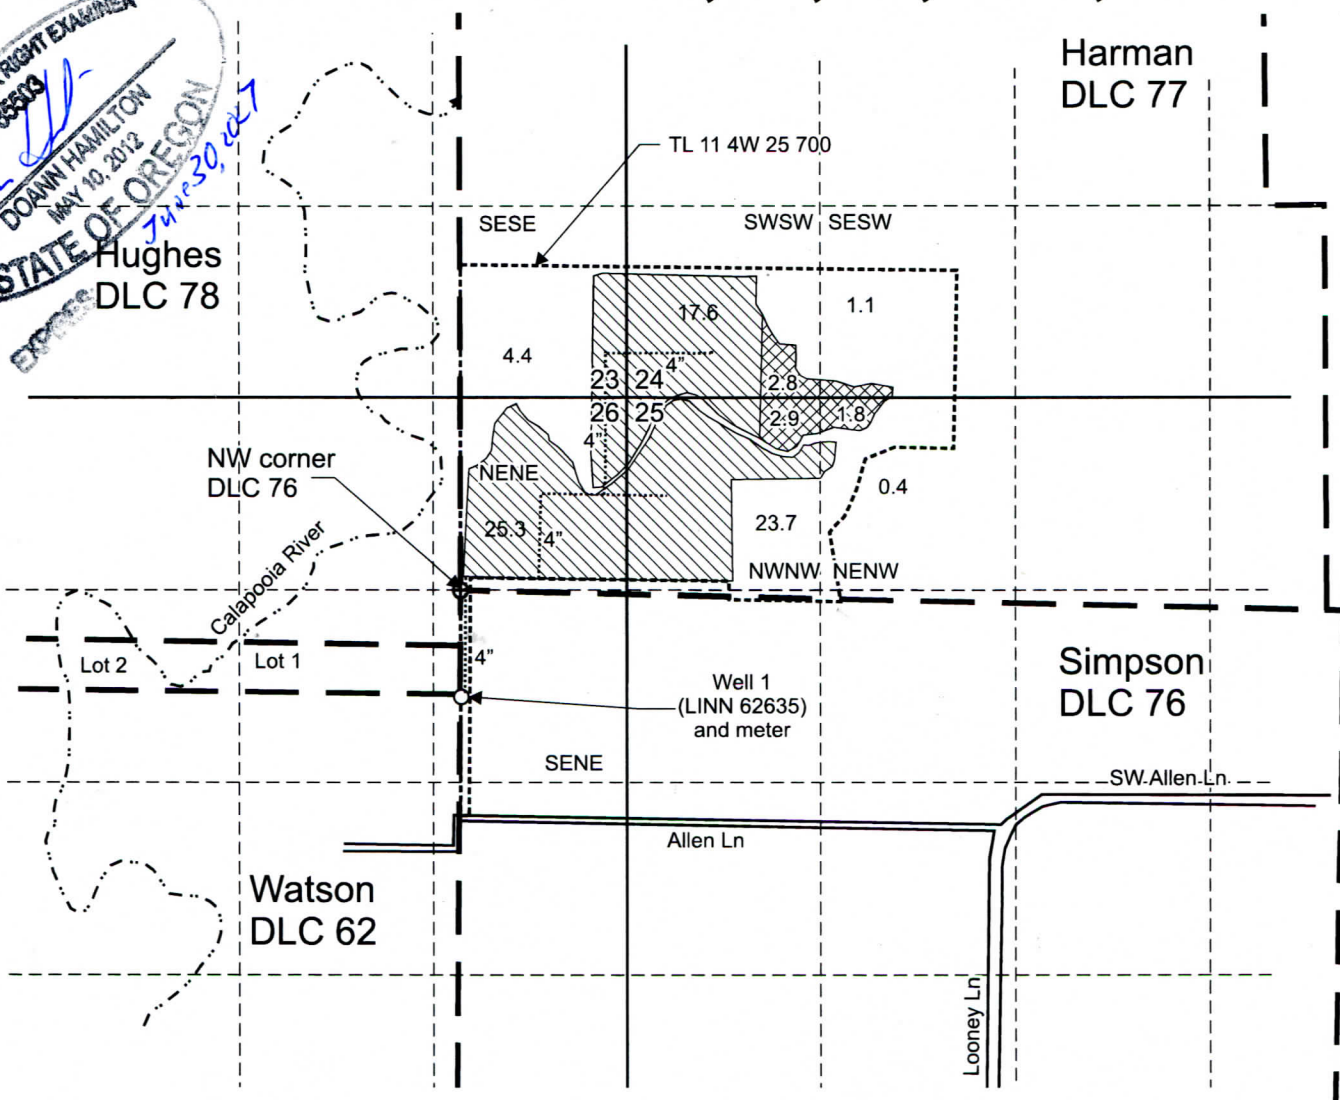

Well 1(LINN 62635) is located 730 feet south and 5 feet east from the NW corner, DLC 76.

Area (71.4 Acres) irrigated under Certificate 98416 Priority date: 11-19-2015, not affected by this transfer.


"From" Area (8.6 Acres) irrigated under Certificate 98416 Priority date: 11-19-2015, affected by this transfer.

----- Tax lot boundary — · — Donation Land Claim boundary Water main line

RECEIVED
SEP 09, 2025
OWRD

SUPERSEDING

Scale: 1" = 1,320'

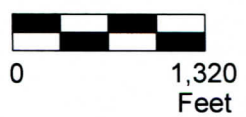

This map was prepared for the purpose of identifying the location of a water right only and is not intended to provide legal dimensions or location of property ownership lines.



Transfer Application "From" Map
Certificate 98416

Pacific Hydro-Geology Inc.

06/2025
Rev. 09/2025

Stanley J. And Lori L. Boshart
T.11S. R.4W. Sec. 23, 24, 25, & 26, W.M.

BoshartBenderCert98416TransMap.cdr

T.11S. R.4W. Sec. 23, 24, 25, & 26, W.M.

CERTIFIED WATER RIGHT EXAMINER
 855513
[Signature]
DOANN HAMILTON
 MAY 10, 2012
STATE OF OREGON


Harman
DLC 77

Hughes
DLC 78


NW corner
DLC 76

Simpson
DLC 76

Watson
DLC 62

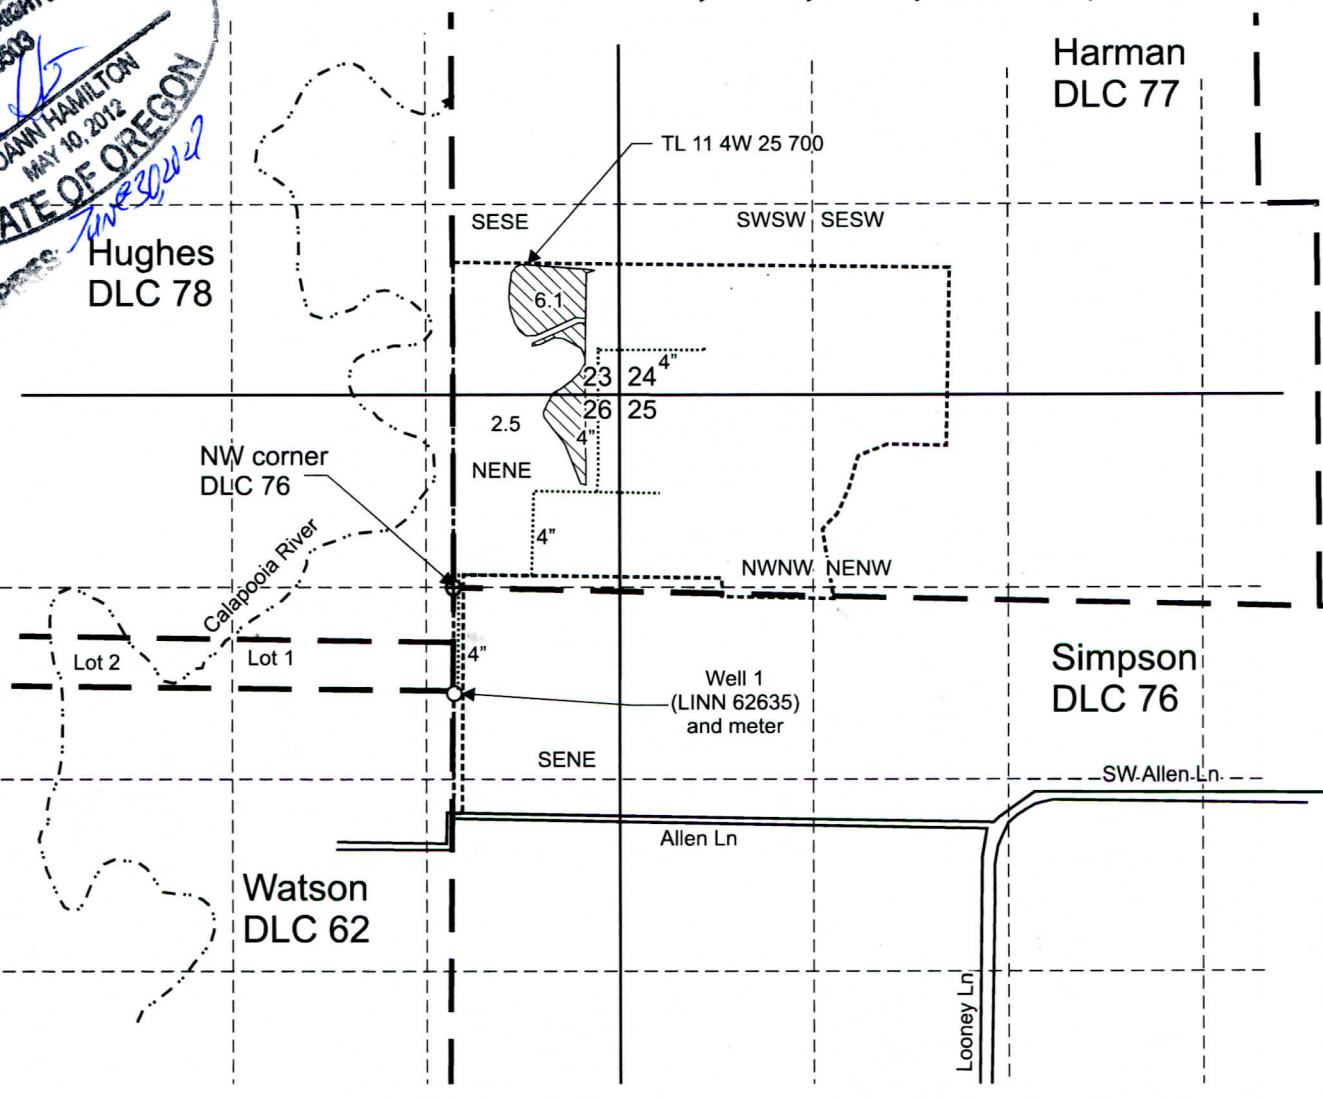

Well 1(LINN 62635) is located 730 feet south and 5 feet east from the NW corner, DLC 76.

 "To" Area (8.6 Acres) to be irrigated.

----- Tax lot boundary — — — — — Donation Land Claim boundary Water main line

RECEIVED
 SEP 09, 2025
 OWRD

SUPERSEDING



Scale: 1" = 1,320'



This map was prepared for the purpose of identifying the location of a water right only and is not intended to provide legal dimensions or location of property ownership lines.

Transfer Application "To" Map
 Certificate 98416

Pacific Hydro-Geology Inc.

06/2025
 Rev. 09/2025

Stanley J. And Lori L. Boshart
 T.11S. R.4W. Sec. 23, 24, 25, & 26, W.M.

BoshartBenderCert98416TransMap.cdr