


**CLAIM OF BENEFICIAL USE T-13710  
 DESERT SPRINGS RANCH LIMITED PARTNERSHIP  
 LOCATED IN THE S 1/2 SW 1/4 OF SECTION 19, T. 15 S.,  
 R. 11 E., W.M., DESCHUTES COUNTY, OREGON**

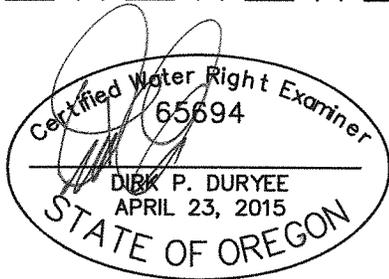


RENEWS: 12-31-27

I, DIRK P. DURYEE, CERTIFIED WATER RIGHT EXAMINER IN THE STATE OF OREGON, HEREBY CERTIFY THE ABOVE CLAIM OF BENEFICIAL USE MAP WAS PREPARED UNDER MY DIRECT SUPERVISION.

THE PREPARATION OF THIS MAP IS FOR THE PURPOSE OF IDENTIFYING THE LOCATION OF THE WATER RIGHT ONLY AND HAS NO INTENT TO PROVIDE DIMENSIONS OR LOCATIONS OF PROPERTY OWNERSHIP LINES.

 50.7 ACRES  
IRRIGATED AREA  
COBU T-13710

WELL - 1200 FEET  
NORTH & 450 FEET  
EAST FROM SW CORNER  
SECTION 19

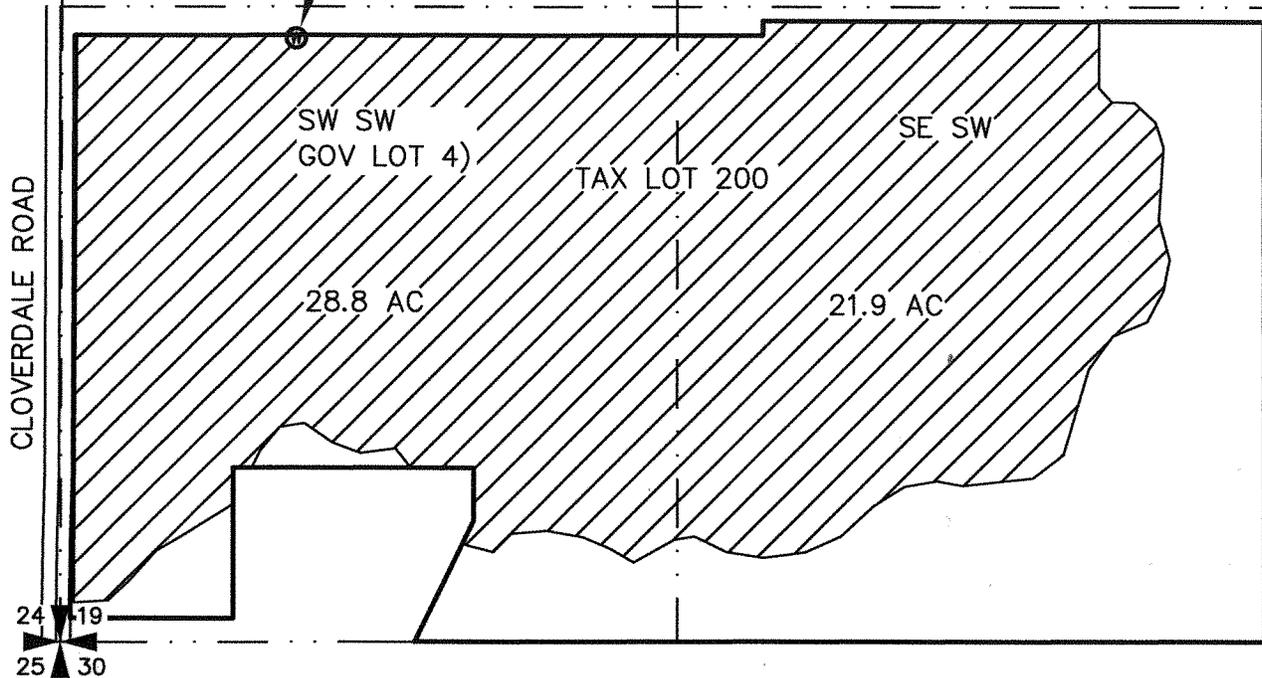

**TYE ENGINEERING, INC.**

725 NW HILL, BEND, OREGON 97703 (541) 389-6959


SCALE: 1"=400'

DRAWN BY: P.A.T.

JOB: 3283-DESERT SPRINGS

DRAWING: 3283\_COBU\_T-13710.dwg