


Sec. 36

T. 35

R. 3 W

This sketch
Prepared in
State Engineer's
office from original
sketch.

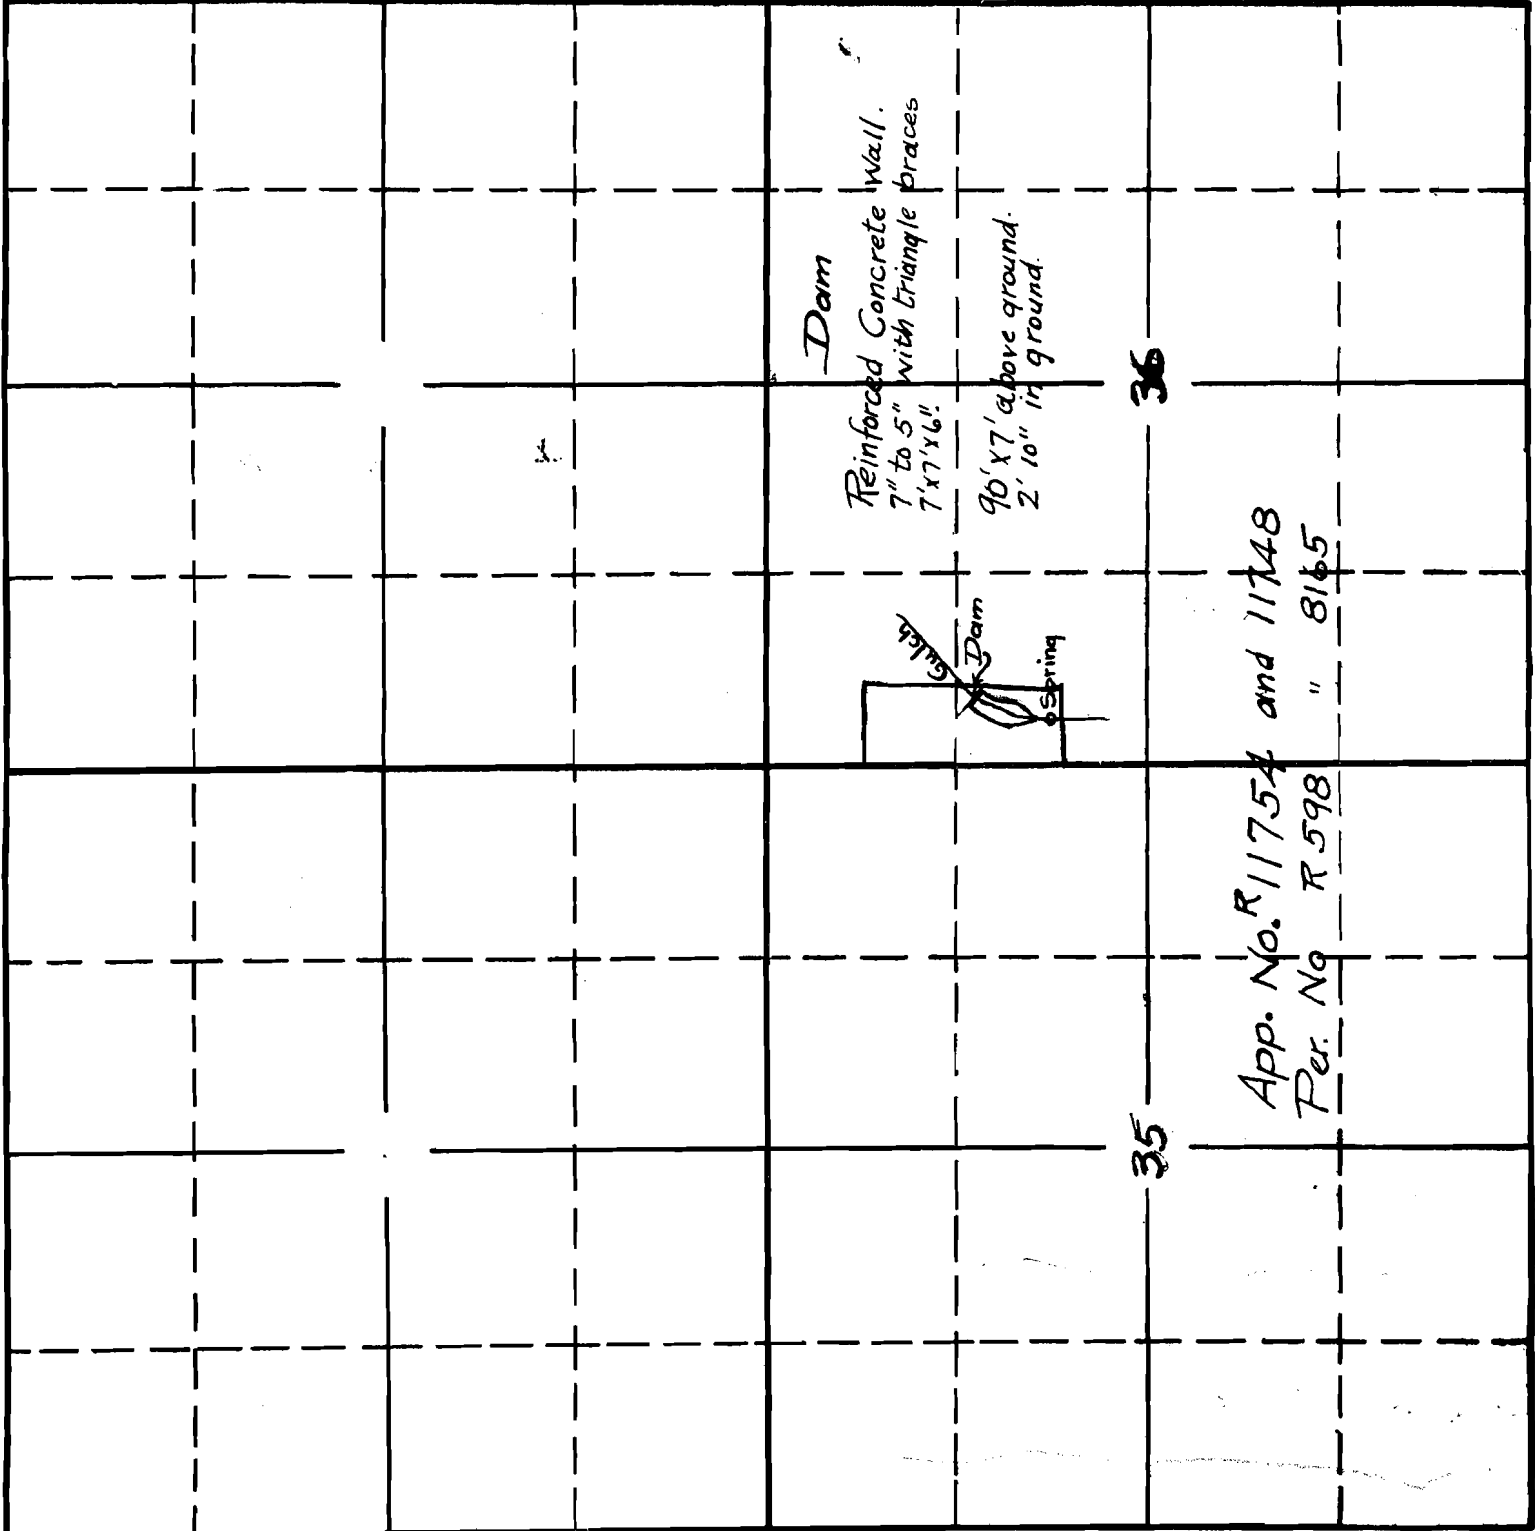

App. No. R 11754 and 11748
Per. No R 598 " 8165