



CLAIM OF BENEFICIAL USE MAP


TO ADD PLACE OF USE AND POINTS OF APPROPRIATION
FOR APPLICATION G-16741

SECTION 32, TOWNSHIP 24 SOUTH, RANGE 31 EAST, W.M.
TAX LOTS: 3400, 3500, & 3600

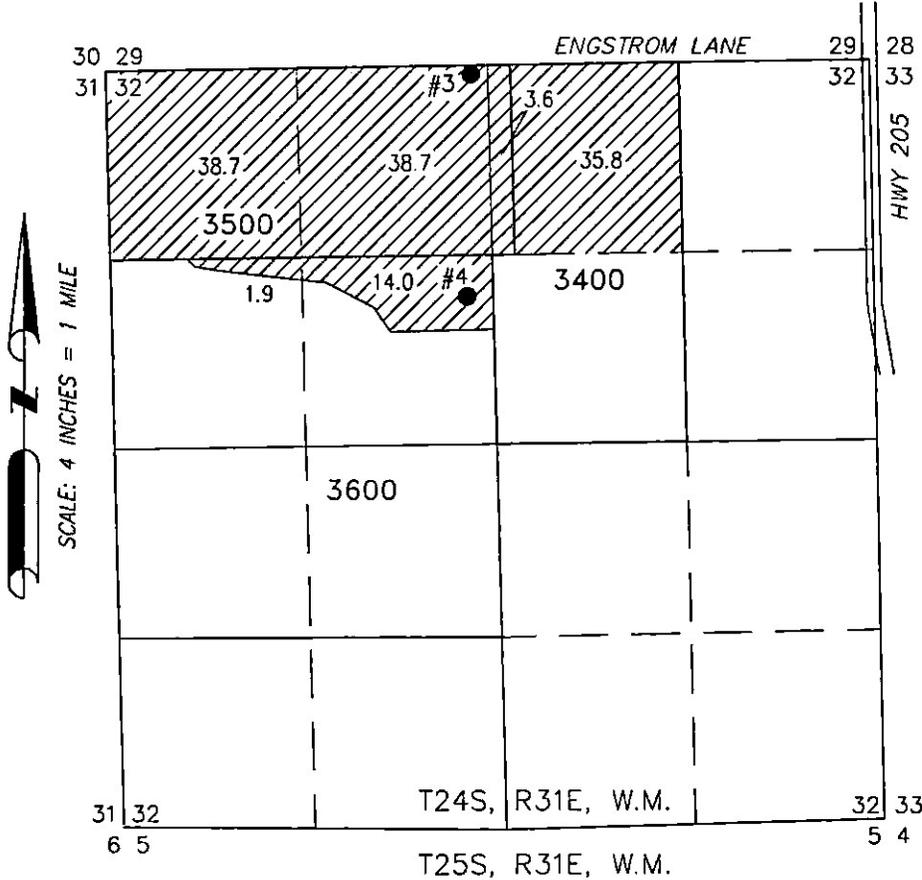

- WELL 3 (HARN 52221)
LOCATED IN THE NE 1/4 NW 1/4 SECTION 32, T24S R31E, W.M. AND 60 FEET SOUTH AND 2510 FEET EAST FROM THE NW CORNER OF SECTION 32. FLOW METER LOCATED 5 FEET WEST FROM WELL.
- WELL 4 (HARN 52055)
LOCATED IN THE SE 1/4 NW 1/4 SECTION 32, T24S R31E, W.M. AND 1580 FEET SOUTH AND 2450 FEET EAST FROM THE NW CORNER OF SECTION 32. FLOW METER LOCATED 2 FEET NORTH FROM WELL.

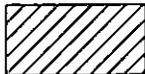 132.7 ACRES 'IR' FROM APPLICATION G-16741 & FROM POAS 3 & 4

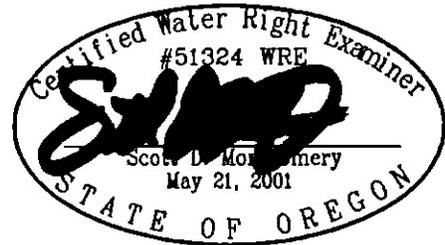

RENEWAL DATE: 12/31/2026

THIS MAP IS FOR THE PURPOSE OF LOCATING A WATER RIGHT ONLY AND HAS NO INTENT TO PROVIDE LEGAL DIMENSIONS OR THE LOCATION OF PROPERTY LINES

<p>PREPARED FOR:</p> <p>KRISTY JORDAN 31144 ENGSTROM LANE BURNS, OR 97720</p>	<p>PREPARED BY:</p> <p> ALL POINTS ENGINEERING AND SURVEYING, INC. P.O. BOX 767 TERREBONNE, OR 97760 (541) 548-5833 www.APEandS.com</p>
---	--