


CLAIM OF BENEFICIAL USE MAP


TO CHANGE PLACE OF USE AND
POINT OF DIVERSION
FOR APPLICATION T-13395
DUNBAR'S SILVIES RIVER RANCH, LLC

TOWNSHIP 23 SOUTH, RANGE 32 EAST, SECTION 27, W.M.
TAX LOT: 4600 HARNEY COUNTY, OREGON

Receiver
Received
JAN 20 2026
OWRD

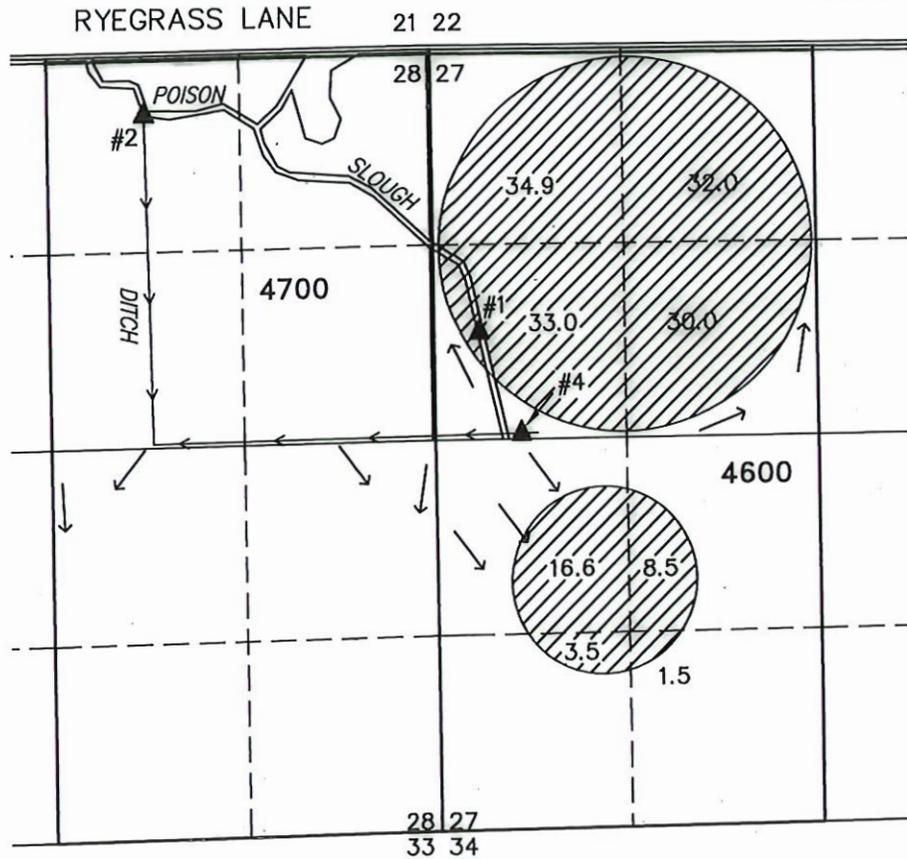

▲ POD #1 IN THE SW 1/4 OF THE NW 1/4 SECTION 27. GRAPHICALLY LOCATED ALONG CANAL MIDWAY BETWEEN N 1/16 & W 1/4 CORNERS OF SECTION 27.

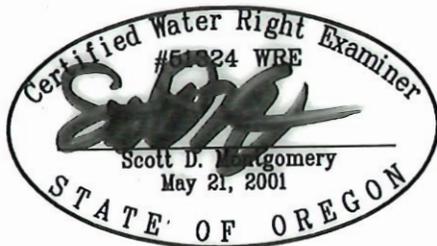

▲ POD #4 IN THE SW 1/4 OF THE NW 1/4 SECTION 27 LOCATED 2600' SOUTH & 590' EAST FROM THE NW CORNER OF SECTION 27.

MEASURING DEVICE LOCATED 30' NORTH FROM POD.

RENEWAL DATE: 12/31/2026

 160.0 ACRES 'IR' FROM POISON CREEK SLOUGH PER T-13395 (PERMIT 3372)

THIS MAP IS FOR THE PURPOSE OF LOCATING A WATER RIGHT ONLY AND HAS NO INTENT TO PROVIDE LEGAL DIMENSIONS OR THE LOCATION OF PROPERTY LINES

PREPARED FOR:

DUNBAR'S SILVIES RIVER RANCH, LLC
9622 VICTOR ROAD
ANCHORAGE, AK 99516

PREPARED BY:



ALL POINTS ENGINEERING AND SURVEYING, INC.
P.O. BOX 767
(541) 548-5833
TERREBONNE, OR 97760
www.APEandS.com