


# CLAIM OF BENEFICIAL USE MAP

TO CHANGE PLACE OF USE AND  
POINT OF DIVERSION  
FOR APPLICATION T-13395  
DUNBAR'S SILVIES RIVER RANCH, LLC

Received  
Received  
JAN 20 2026  
OWRD

TOWNSHIP 23 SOUTH, RANGE 32 EAST, SECTION 27, W.M.  
TAX LOT: 4600 HARNEY COUNTY, OREGON

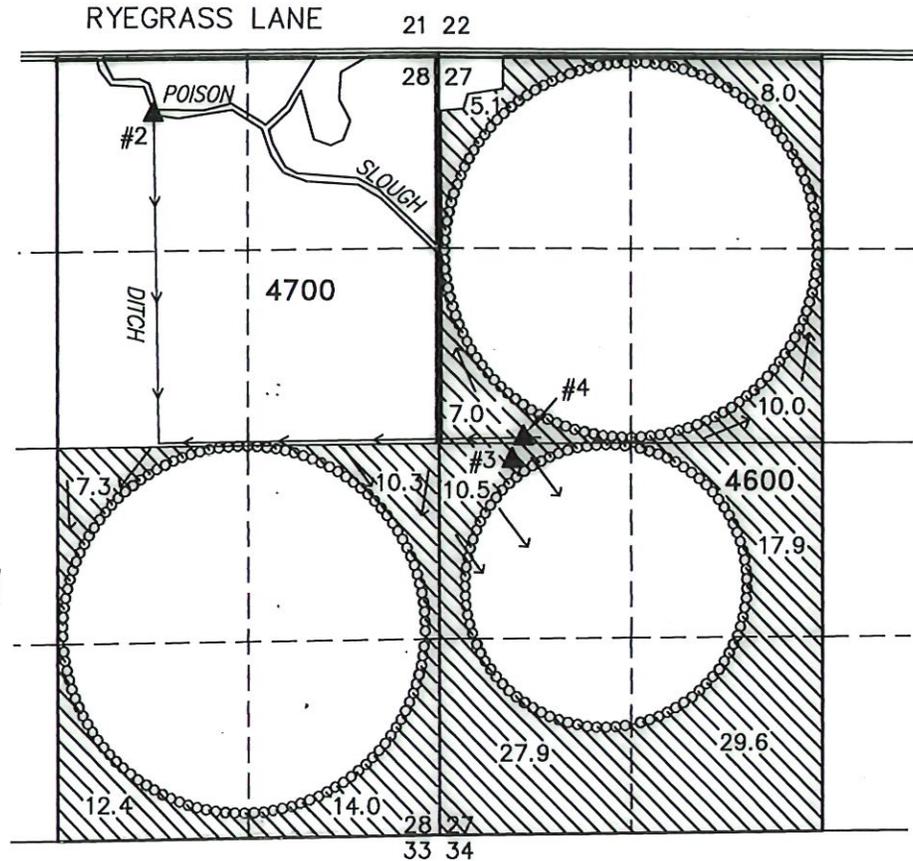

▲ POD #3 IN THE NW 1/4 OF THE SW 1/4 SECTION 27. LOCATED S 79°27' E 518' FROM THE W 1/4 CORNER OF SECTION 27.

▲ POD #4 IN THE SW 1/4 OF THE NW 1/4 SECTION 27 LOCATED 2600' SOUTH & 590' EAST FROM THE NW CORNER OF SECTION 27.


MEASURING DEVICE LOCATED 30' NORTH FROM POD.



RENEWAL DATE: 12/31/2026

 160.0 ACRES 'R' FROM POISON CREEK SLOUGH CERTIFICATE 11060 (PERMIT 7570) TRANSFERRED ON.

THIS MAP IS FOR THE PURPOSE OF LOCATING A WATER RIGHT ONLY AND HAS NO INTENT TO PROVIDE LEGAL DIMENSIONS OR THE LOCATION OF PROPERTY LINES

  PERIMETER BERM

PREPARED FOR:

DUNBAR'S SILVIES RIVER RANCH, LLC  
9622 VICTOR ROAD  
ANCHORAGE, AK 99516

PREPARED BY:



ALL POINTS ENGINEERING AND SURVEYING, INC.  
P.O. BOX 767  
(541) 548-5833  
TERREBONNE, OR 97760  
www.APEandS.com