


CLAIM OF BENEFICIAL USE MAP

TO CHANGE PLACE OF USE AND
POINT OF DIVERSION
FOR APPLICATION T-13395
DUNBAR'S SILVIES RIVER RANCH, LLC

Received
JAN 20 2026

TOWNSHIP 23 SOUTH, RANGE 32 EAST, SECTION 27, W.M.
TAX LOT: 4600 HARNEY COUNTY, OREGON

OWRD

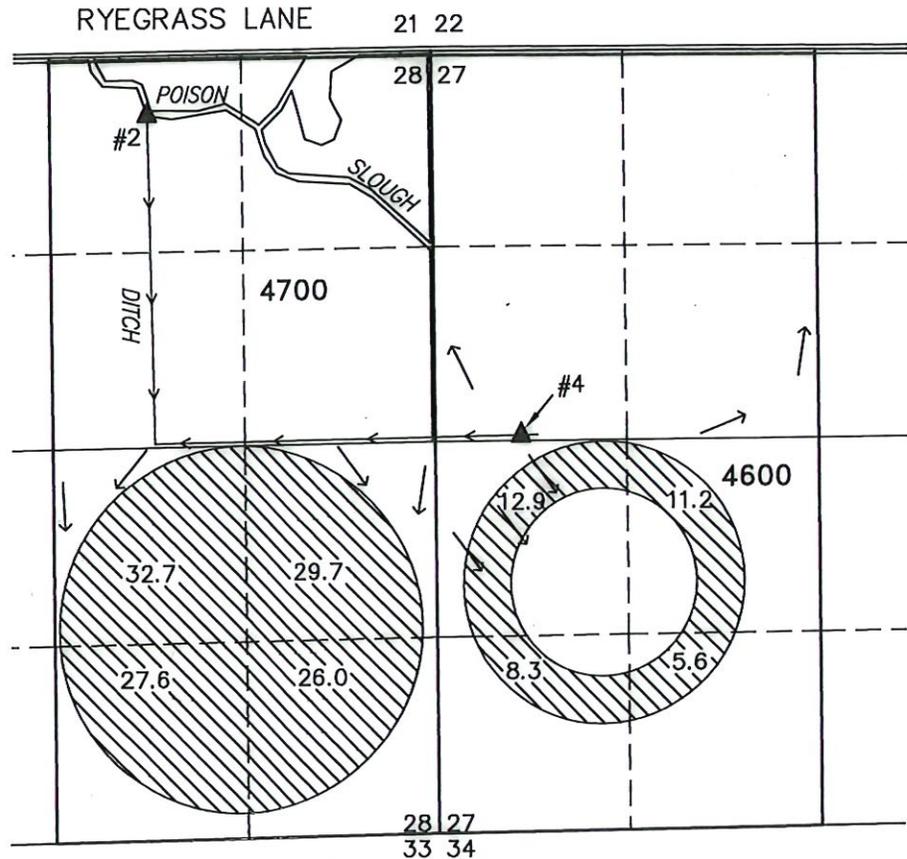

▲ POD #2 IN THE NW 1/4 OF THE NE 1/4 SECTION 28. LOCATED 4880' N & 1940' W FROM THE SE CORNER OF SECTION 28.

▲ POD #4 IN THE SW 1/4 OF THE NW 1/4 SECTION 27 LOCATED 2600' SOUTH & 590' EAST FROM THE NW CORNER OF SECTION 27.

MEASURING DEVICE LOCATED 30' NORTH FROM POD.



RENEWAL DATE: 12/31/2026

THIS MAP IS FOR THE PURPOSE OF LOCATING A WATER RIGHT ONLY AND HAS NO INTENT TO PROVIDE LEGAL DIMENSIONS OR THE LOCATION OF PROPERTY LINES

 154.0 ACRES 'IR' FROM POISON CREEK SLOUGH PER T-13395 (PERMIT 25838).

PREPARED FOR:

DUNBAR'S SILVIES RIVER RANCH, LLC
9622 VICTOR ROAD
ANCHORAGE, AK 99516

PREPARED BY:



ALL POINTS ENGINEERING AND SURVEYING, INC.
P.O. BOX 767 TERREBONNE, OR 97760
(541) 548-5833 www.APEandS.com