


# CLAIM OF BENEFICIAL USE MAP

TO CHANGE PLACE OF USE AND  
ADD POINTS OF APPROPRIATION  
FOR APPLICATION T-13395  
DUNBAR'S SILVIES RIVER RANCH, LLC

TOWNSHIP 23 SOUTH, RANGE 32 EAST, SECTION 27, W.M.  
TAX LOT: 4600 HARNEY COUNTY, OREGON

Received  
JAN 28 2026

OWRD  
2026

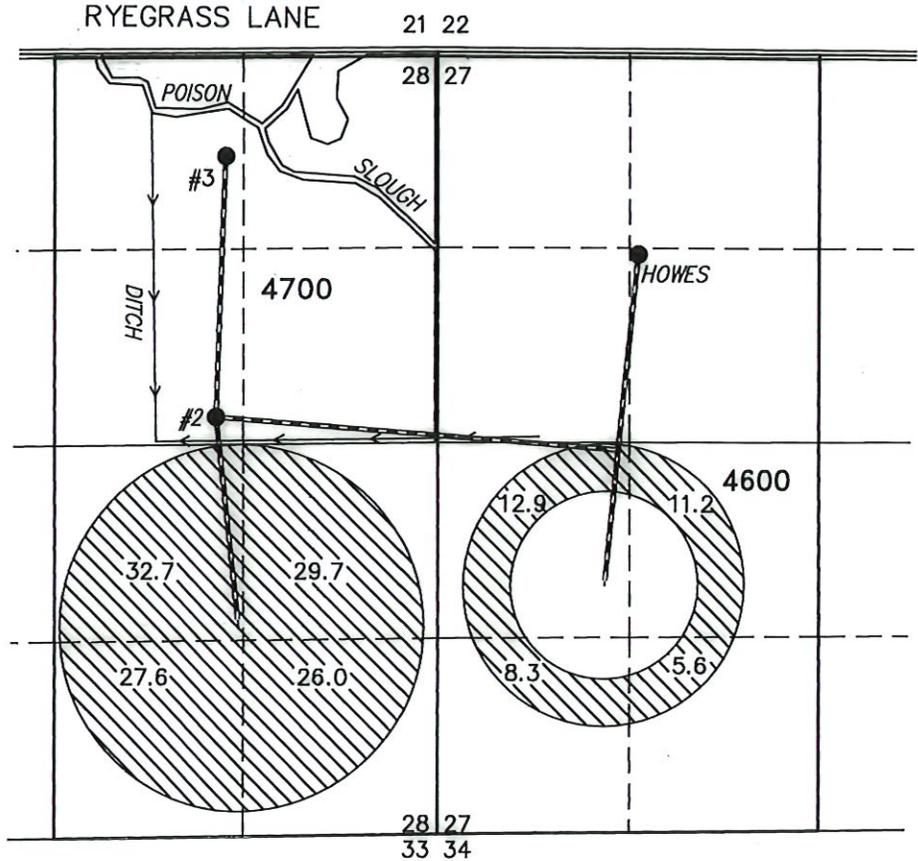

 154.0 ACRES 'IS' FROM  
WELLS HOWE, #2, & #3 PER  
T-13395 (PERMIT G-1484)



RENEWAL DATE: 12/31/2026

- WELL #2 (HARN 602) IN THE SW 1/4 OF THE NE 1/4 SECTION 28 & 2890' NORTH & 1520' WEST FROM THE SE CORNER SECTION 28.  
FLOWMETER IS LOCATED 4.0' SE'LY FROM WELL.
- HOWES WELL (HARN 592) IN THE SE 1/4 OF THE NW 1/4 SECTION 27 & 20.5 CHAINS SOUTH & 21 CHAINS EAST FROM THE NW CORNER SECTION 27.  
FLOWMETER IS LOCATED 6.0' S'LY FROM WELL.
- WELL #3 (HARN 52832) IN THE NW 1/4 OF THE NE 1/4 SECTION 28 & 700' SOUTH & 1450' WEST FROM THE NE CORNER OF SECTION 28.  
FLOWMETER IS LOCATED 7.0' S'LY FROM WELL.

THIS MAP IS FOR THE PURPOSE OF LOCATING A WATER RIGHT ONLY AND HAS NO INTENT TO PROVIDE LEGAL DIMENSIONS OR THE LOCATION OF PROPERTY LINES

<p>PREPARED FOR:</p> <p>DUNBAR'S SILVIES RIVER RANCH, LLC 9622 VICTOR ROAD ANCHORAGE, AK 99516</p>	<p>PREPARED BY:</p>  <p>ALL POINTS ENGINEERING AND SURVEYING, INC. P.O. BOX 767 (541) 548-5833 www.APEandS.com</p> <p>TERREBONNE, OR 97760</p>
--	---