

TRANSFER APPLICATION MAP
IN THE NAME OF FESSLER FAMILY LLC

RECEIVED


JUN 10 2015

WATER RESOURCES DEPT
SALEM, OREGON

T.6S.,R.2W.,W.M.



4" = 1 mile

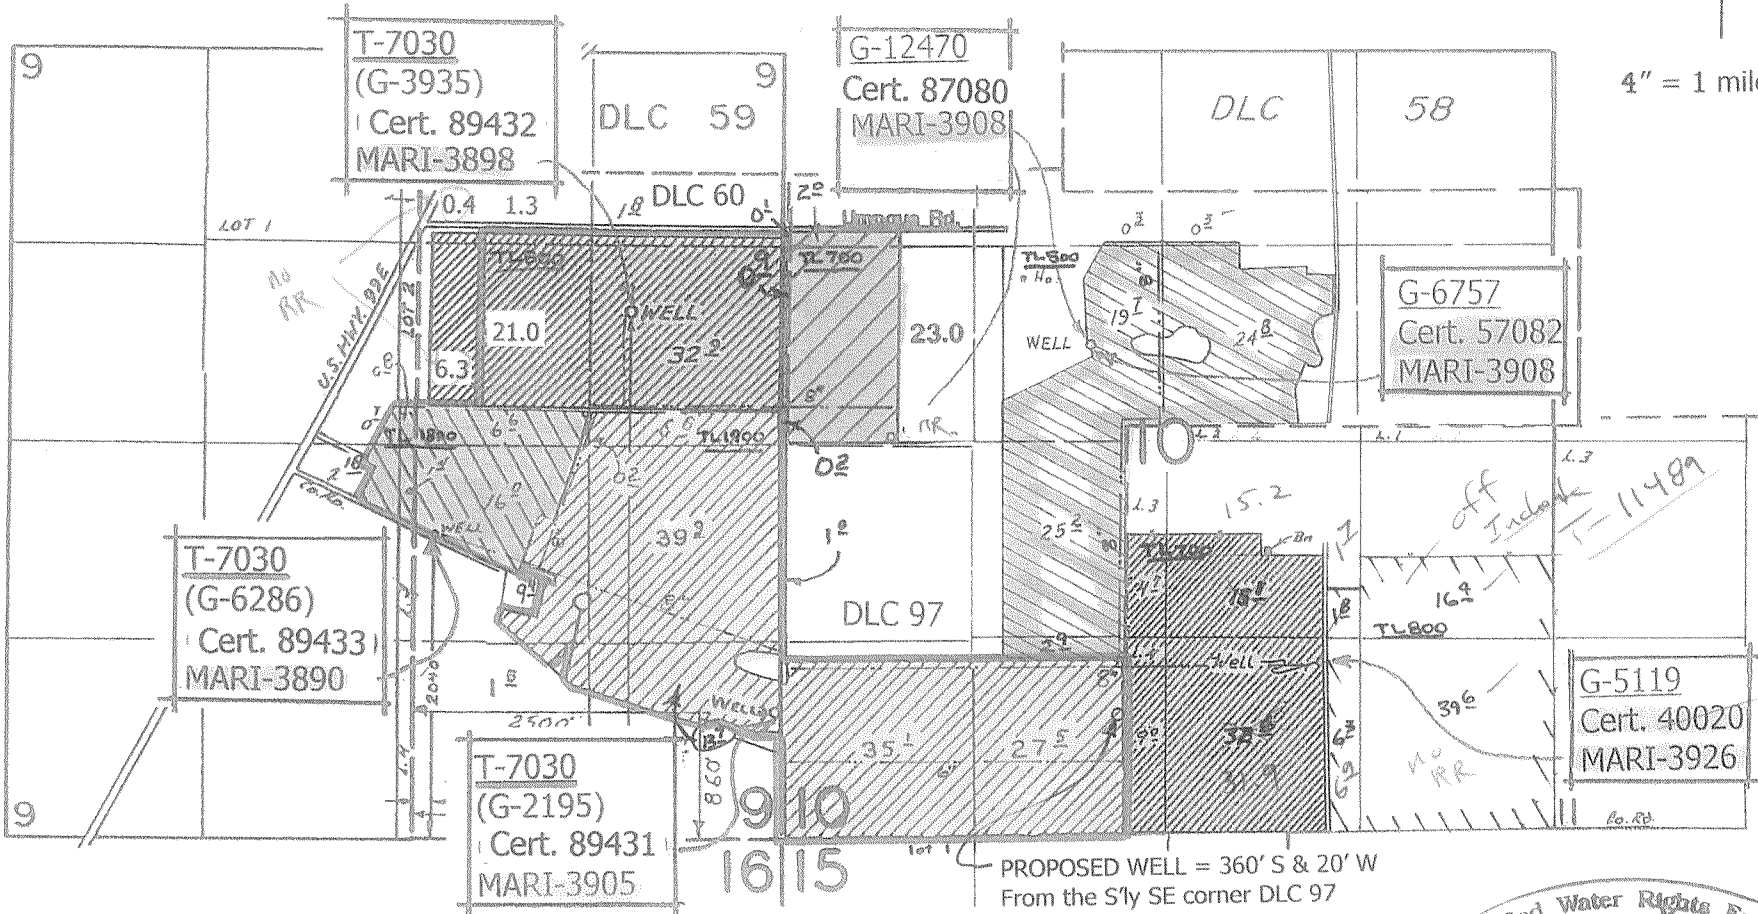


COPY

- pipeline -----
- Tax Lot line _____
- Section line _____
- 1/4 1/4 line _____
- DLC line -----

#3926 = 1150' N & 1580' W from the SE cor sec 10 ✓
#3908 = 2120' N & 230' W from the sly SE cor DLC 97

#3905 = 340' S & 70' W from the SW cor DLC 97
#3898 = 3530' N & 1470' E from the SW cor DLC 60
#3890 = 2040' N & 140' E from the SW cor DLC 60

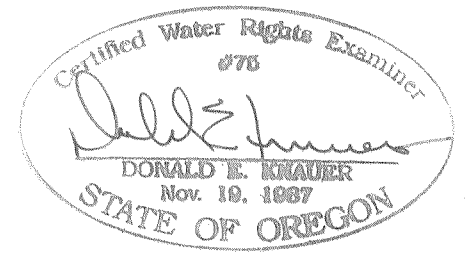

RENEWAL DATE 6-30-2015


TRANSFER APPLICATION MAP
IN THE NAME OF FESSLER FAMILY LLC

RECEIVED

JUN 10 2015

WATER RESOURCES DEPT
SALEM, OREGON


T.6S.,R.2W.,W.M.

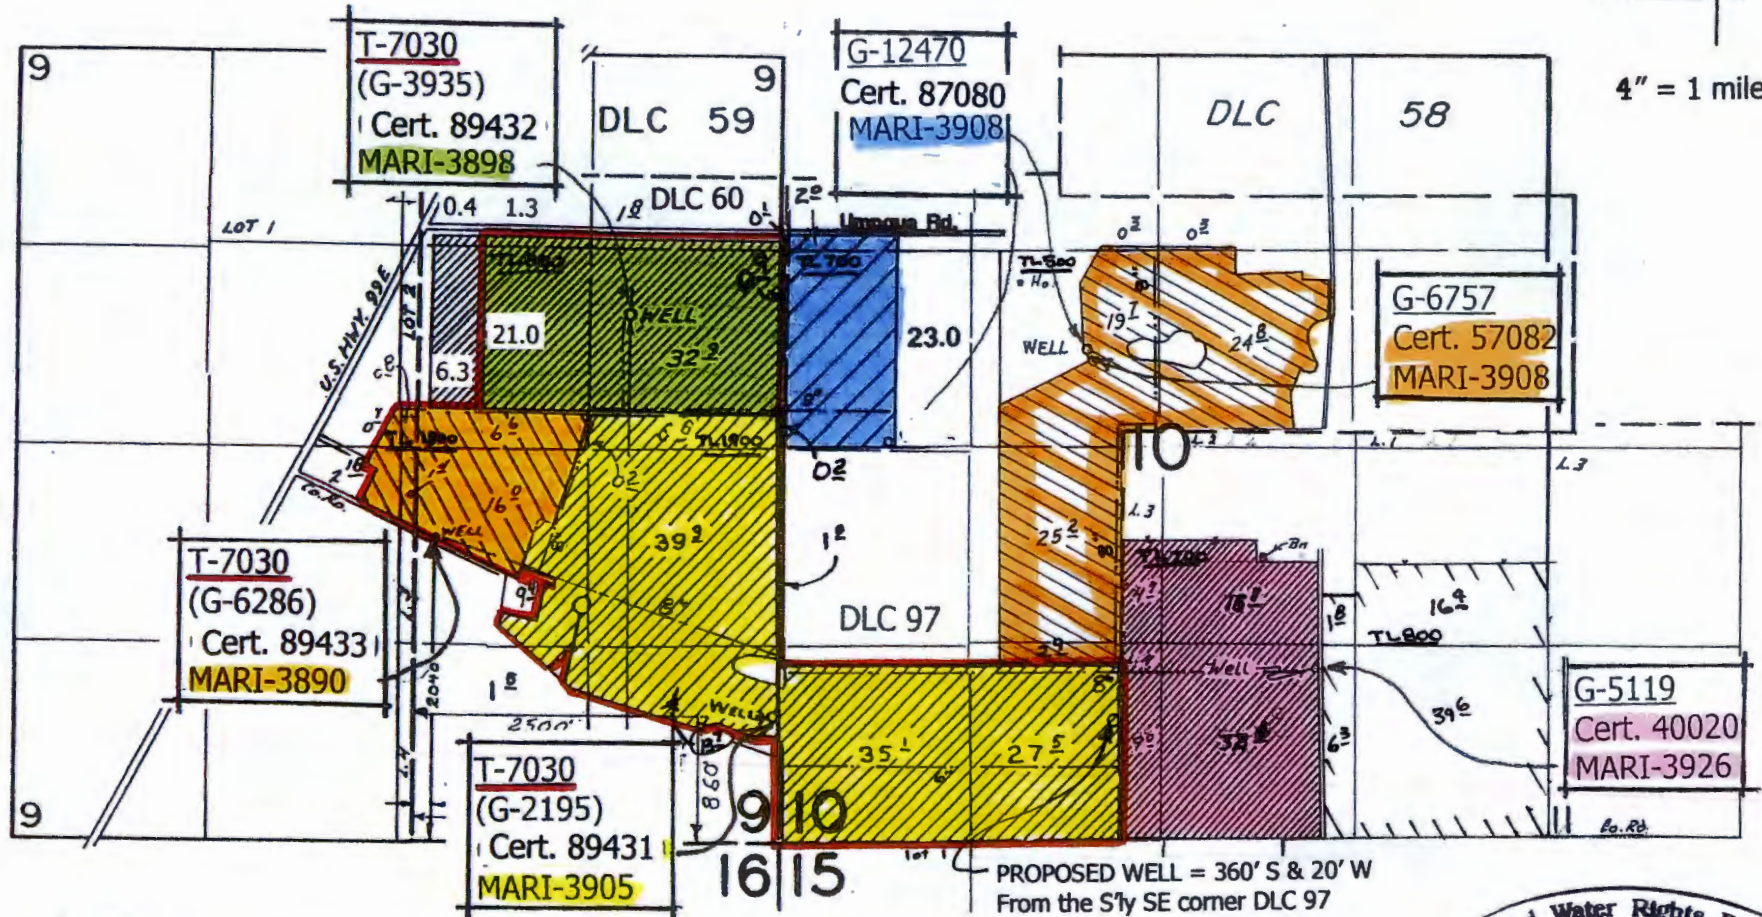

- pipeline ----
- Tax Lot line ———
- Section line ———
- 1/4 1/4 line ———
- DLC line ———

- #3926 = 1150' N & 1580' W from the SE cor sec 10
- #3908 = 2120' N & 230' W from the sly SE cor DLC 97
- #3905 = 340' S & 70' W from the SW cor DLC 97
- #3898 = 3530' N & 1470' E from the SW cor DLC 60
- #3890 = 2040' N & 140' E from the SW cor DLC 60

T 12073

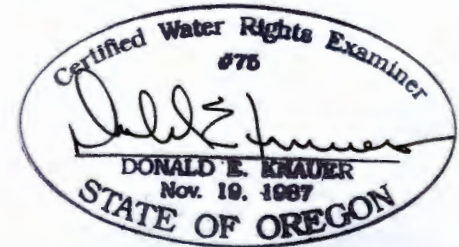


RENEWAL DATE: 6-30-2015

MAP FOR


Claim of Beneficial Use

S9 & S10, T6S, R2W, MARION COUNTY

Transfer T-12078

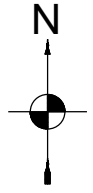

1 IN = 1320 FT
0 660 1320

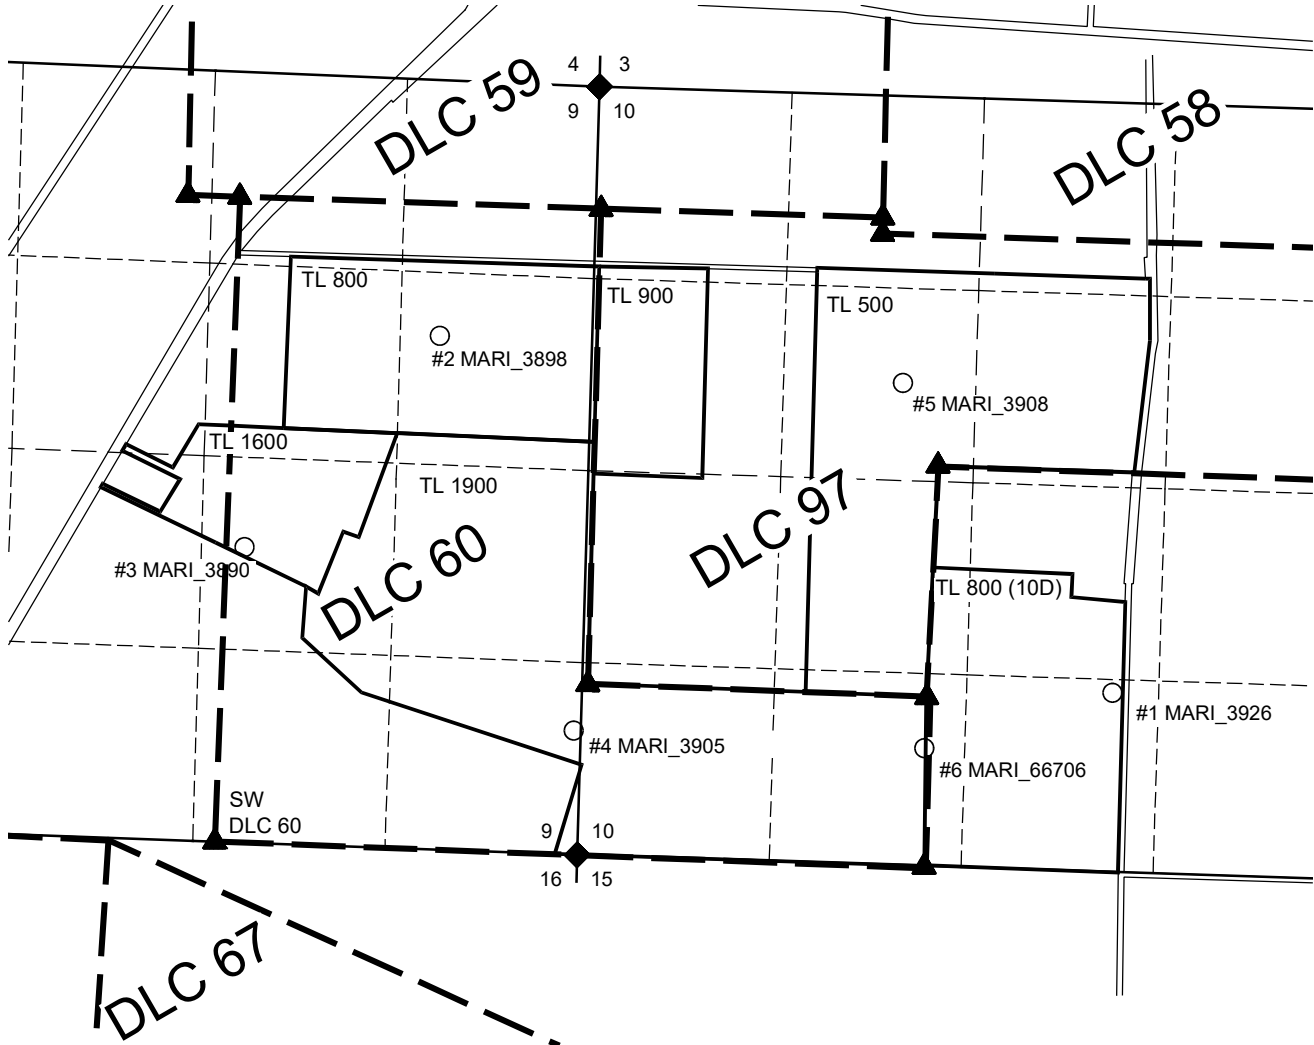

NOTES:

- THIS MAP IS NOT INTENDED TO PROVIDE LEGAL DIMENSIONS OR LOCATIONS OF PROPERTY OWNERSHIP LINES.
- PROPERTY LINES, QUARTER-QUARTER LINES, AND DLC LINES ARE BASED ON THE TAX ASSESSOR MAP FOR SECTIONS 9 & 10, T6S, R2W.
- POA LOCATIONS ARE BASED ON AERIAL PHOTO INTERPRETATION AND DO NOT NECESSARILY MATCH PREVIOUSLY RECORDED COORDINATES.
- ALL POA'S HAVE METERS AT THE POA LOCATION.
- WATER CONVEYANCE LINES ARE WITHIN THE PROPERTY AND ARE NOT SHOWN.
- NO SIGNIFICANT STREAMS WERE FOUND IN THE AREA.

LOCATIONS OF POA'S

- POA #1 1020' N & 6170' E
- POA #2 3475' N & 1545' E
- POA #3 2025' N & 205' E
- POA #4 760' N & 2470' E
- POA #5 3150' N & 4730' E
- POA #6 640' N & 4880' E
- ALL FROM SW DLC 60



Exp. 30 JUN 2026

LEGEND

- ▲ DONATION LAND CLAIM (DLC) CORNER
- ◆ SECTION CORNER
- POINT OF APPROPRIATION (POA), POA NUMBER
- - - - - STREAM OR SURFACE DRAINAGE
- TAX LOT LINE
- SECTION LINE
- - - - - QUARTER-QUARTER LINE
- - - - - DLC LINES

MAP BY:
ASPEN RURAL LAND CONSULTING

ERIC URSTADT, PE, PLS
971-250-1520
JAN 2026
Fessler-Kuenzi2A