


CLAIM OF BENEFICIAL USE MAP

T6S, R4W, SECTIONS 23, TAX LOTS 200+300+900, W.M.
POLK COUNTY

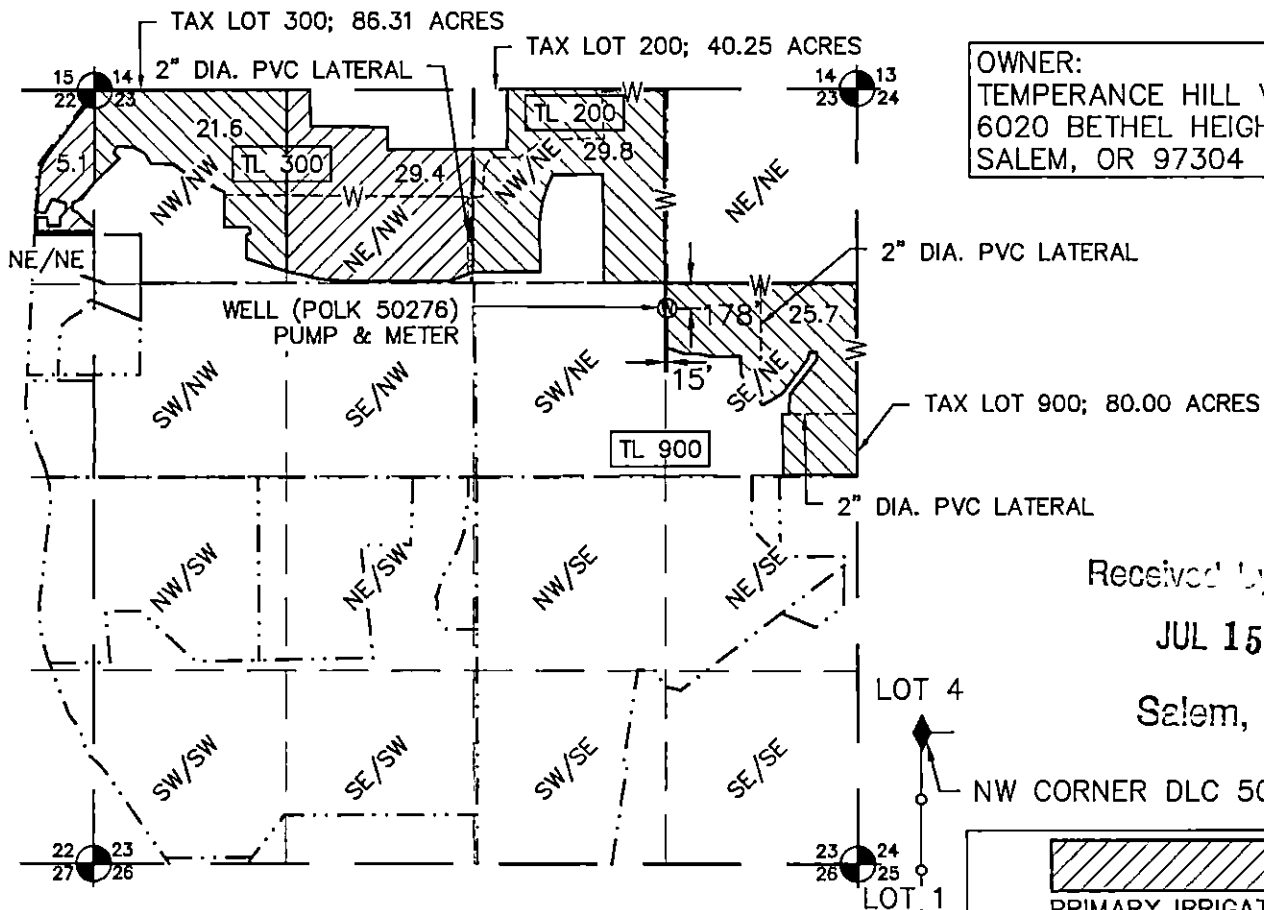

OWNER:
TEMPERANCE HILL VINEYARD
6020 BETHEL HEIGHTS ROAD
SALEM, OR 97304

Received by CWRD

JUL 15 2025

Salem, OR

NW CORNER DLC 50 PHILLIPS

POA	TWP	RNG	SEC	Q-Q	TL	MEASURED DISTANCE
WELL	6S	4W	23	SE NE	900	178'S AND 15'E FROM SW CORNER OF THE NE 1/4, NE 1/4 OF SECTION 23

PRIMARY IRRIGATION
APP G-13820
PERMIT G-15777
111.6 ACRES (144.7 PERMITTED)


PLACE OF USE

TWP	RNG	SEC	Q-Q	TL	LOT	DLC	AC
6S	4W	23	NW NE	200	-	-	29.8
6S	4W	23	SW NE	900	-	-	0.0
6S	4W	23	SE NE	900	-	-	25.7
6S	4W	23	NE NW	300	-	-	29.4
6S	4W	23	NW NW	300	-	-	21.6
6S	4W	22	NE NE	300	-	-	5.1
TOTAL ACRES							111.6

NOTE: THIS MAP IS PRODUCED TO
APPLY FOR THE BENEFICIAL USE OF A
WATER RIGHT. IT IS NOT INTENDED TO
PROVIDE INFORMATION RELATIVE TO
THE LOCATION OF PROPERTY LINES.

BLUNDON
ENGINEERING, LLC

PO BOX 786
HILLSBORO, OREGON 97123
541-510-5910
NICK@BLUNDONENGINEERING.COM

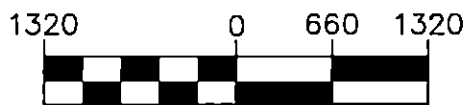

1 inch = 1320ft.
PRINT SCALE=8.5"x11"

- LEGEND**
- SECTION LINE
 - 1/4 1/4 LINE
 - DLC LINE
 - PROPERTY LINE
 - WELL
 - SECTION CORNER
 - DLC CORNER
 - 3" DIA. PVC BURIED IRR. MAIN

Certified Water Right Examiner
#83725
Nicholas G. Blundon
NICHOLAS GORDON BLUNDON
MAY 14, 2019
STATE OF OREGON
EXPIRES 12/31/2025