

# CLAIM OF BENEFICIAL USE MAP

FOR: DAVID & BLANCA SANCHEZ HELBOCK

BY: NATHAN R. REED, P.E., CWRE  
 T27S, R6W, W.M. SECTION 5, GLOT 6  
 APPLICATION NO. S-88177  
 PERMIT NO. S-55039




SCALE: 1" = 400'

DATE SURVEYED: AUGUST 3, 2018

RECEIVED

AUG 15 2018

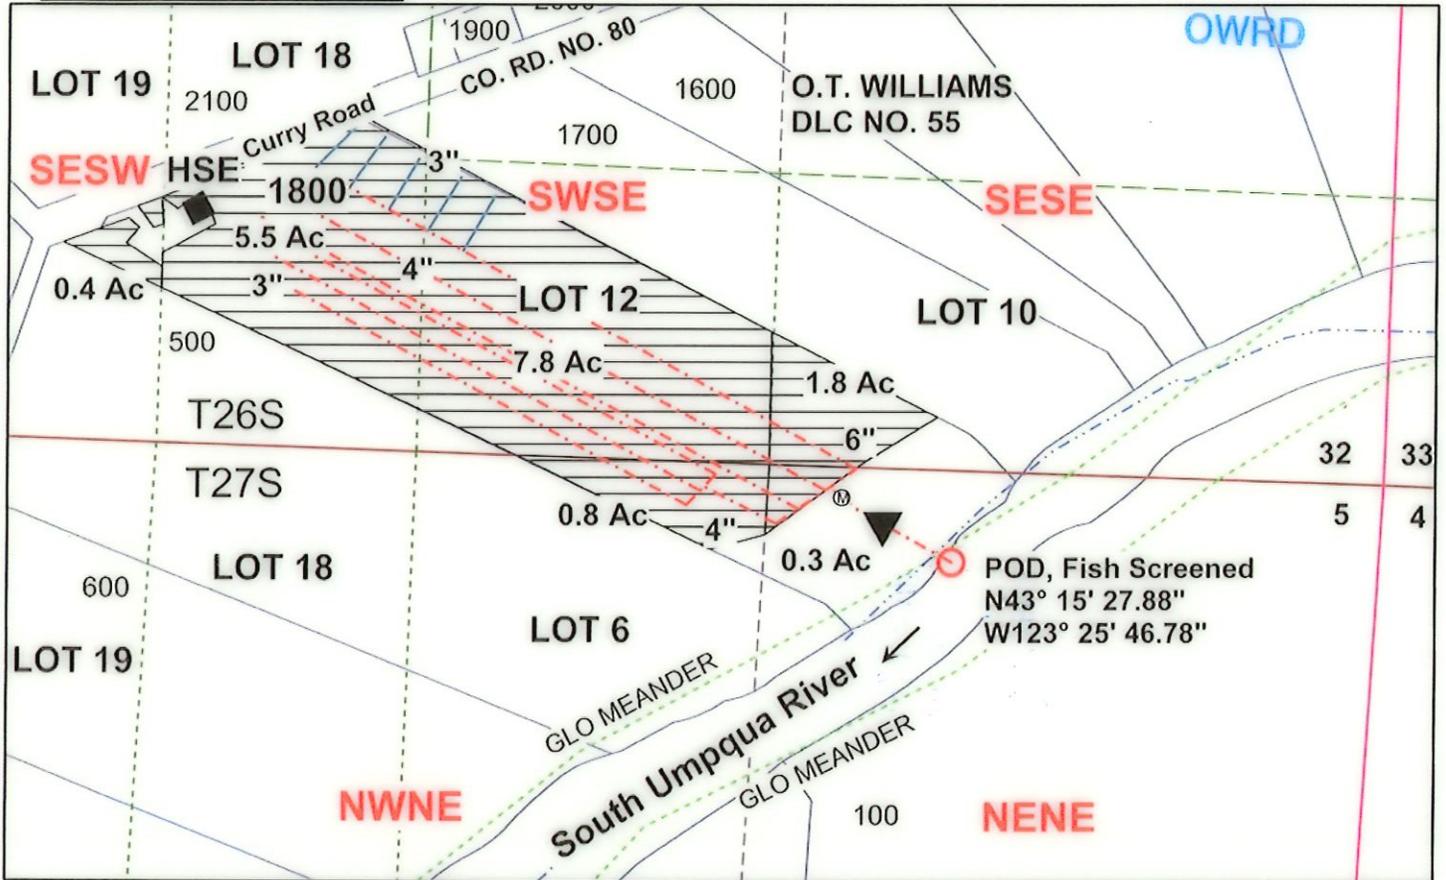


POD IS LOCATED 100 FEET SOUTH AND 850 FEET WEST FROM THE NE CORNER OF SECTION 5

### Legend

- |  |               |  |              |  |           |
|--|---------------|--|--------------|--|-----------|
|  | Stream        |  | Lateral Line |  | DLC       |
|  | Flow arrow    |  | Structure    |  | Section   |
|  | POD           |  | Meander      |  | Quarter   |
|  | Pump          |  | Gov Lot      |  | Sixteenth |
|  | Meter         |  | Township     |  | Parcels   |
|  | Main Pipeline |  |              |  |           |

MAP PREPARED FOR:  
 DAVID & BLANCA SANCHEZ HELBOCK  
 1806 CURRY ROAD  
 ROSEBURG, OR 97471

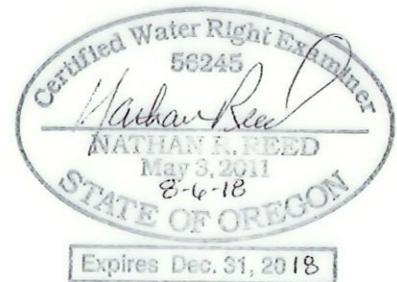

Expires Dec. 31, 2018

THE PURPOSE OF THIS MAP IS TO IDENTIFY THE LOCATION OF THE WATER RIGHT. IT IS NOT INTENDED TO PROVIDE INFORMATION RELATIVE TO THE LOCATION OF PROPERTY OWNERSHIP BOUNDARY LINES.

MAP PREPARED BY:  
 NATHAN R. REED, P.E., CWRE  
 157 W. BODIE ST  
 ROSEBURG, OR 97471