
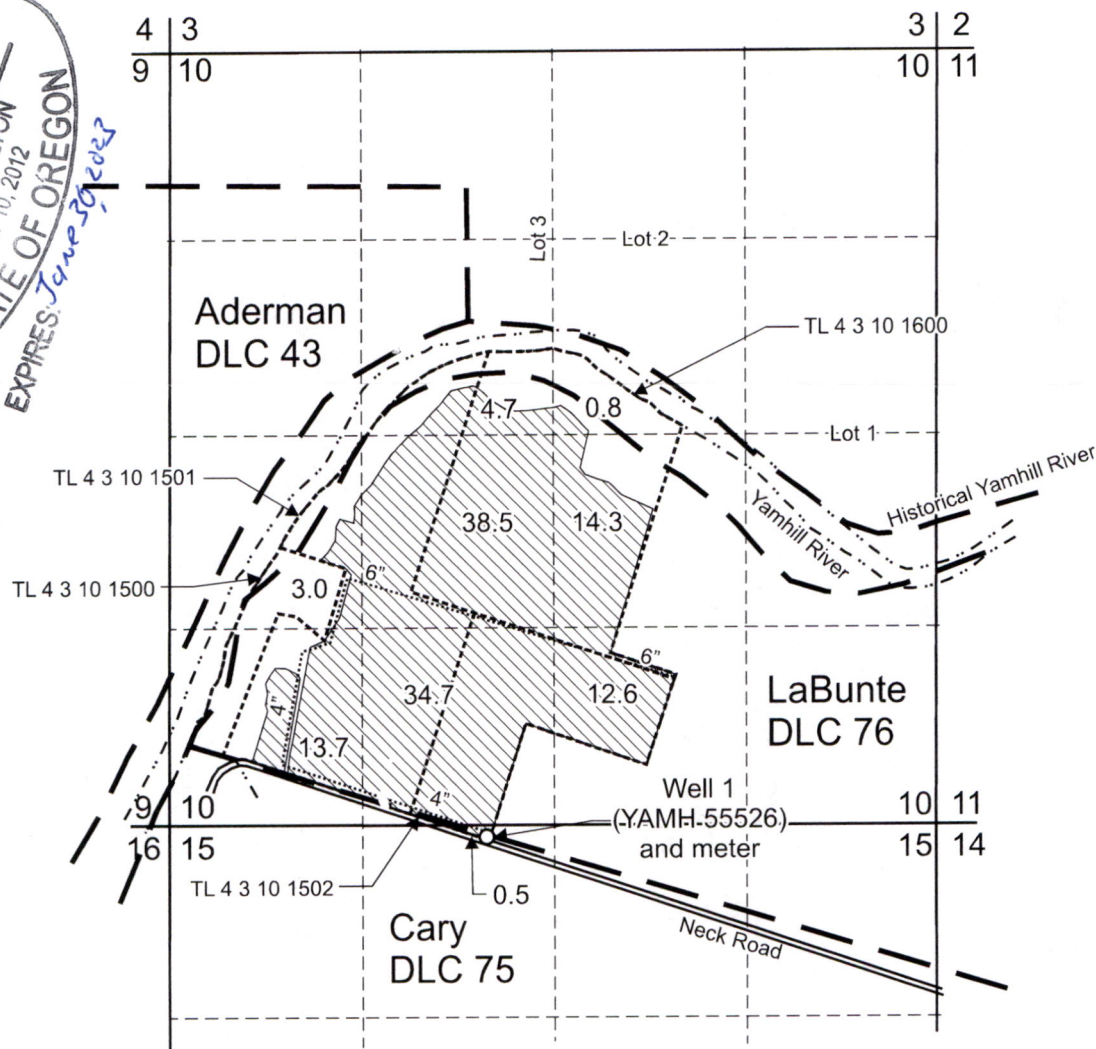


RECEIVED

NOV 03 2022

OWRD

T.4S. R.3W. Section 10, W.M.

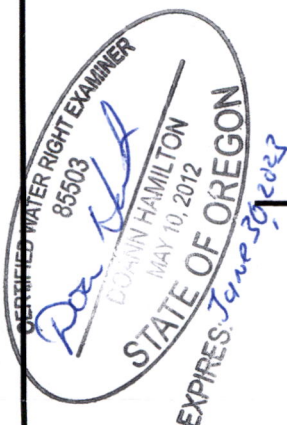

Well 1 (YAMH 55526) is located 100 feet south and 2,190 feet east from the NW corner, Section 15.

 Area (122.8 Acres) nursery use under Application G-16412, Permit G-16229.

----- Tax lot boundary - - - - - Donation Land Claim boundary Water main line

Scale: 1" = 1,320'



This map was prepared for the purpose of identifying the location of a water right only and is not intended to provide legal dimensions or location of property ownership lines.

Claim of Beneficial Use Map
Application G-16412, Permit G-16229

Pacific Hydro-Geology Inc.

08/2022

Arne Goddik
T.4S. R.3W. Section 10, W.M.