


CLAIM OF BENEFICIAL USE SURVEY G17742

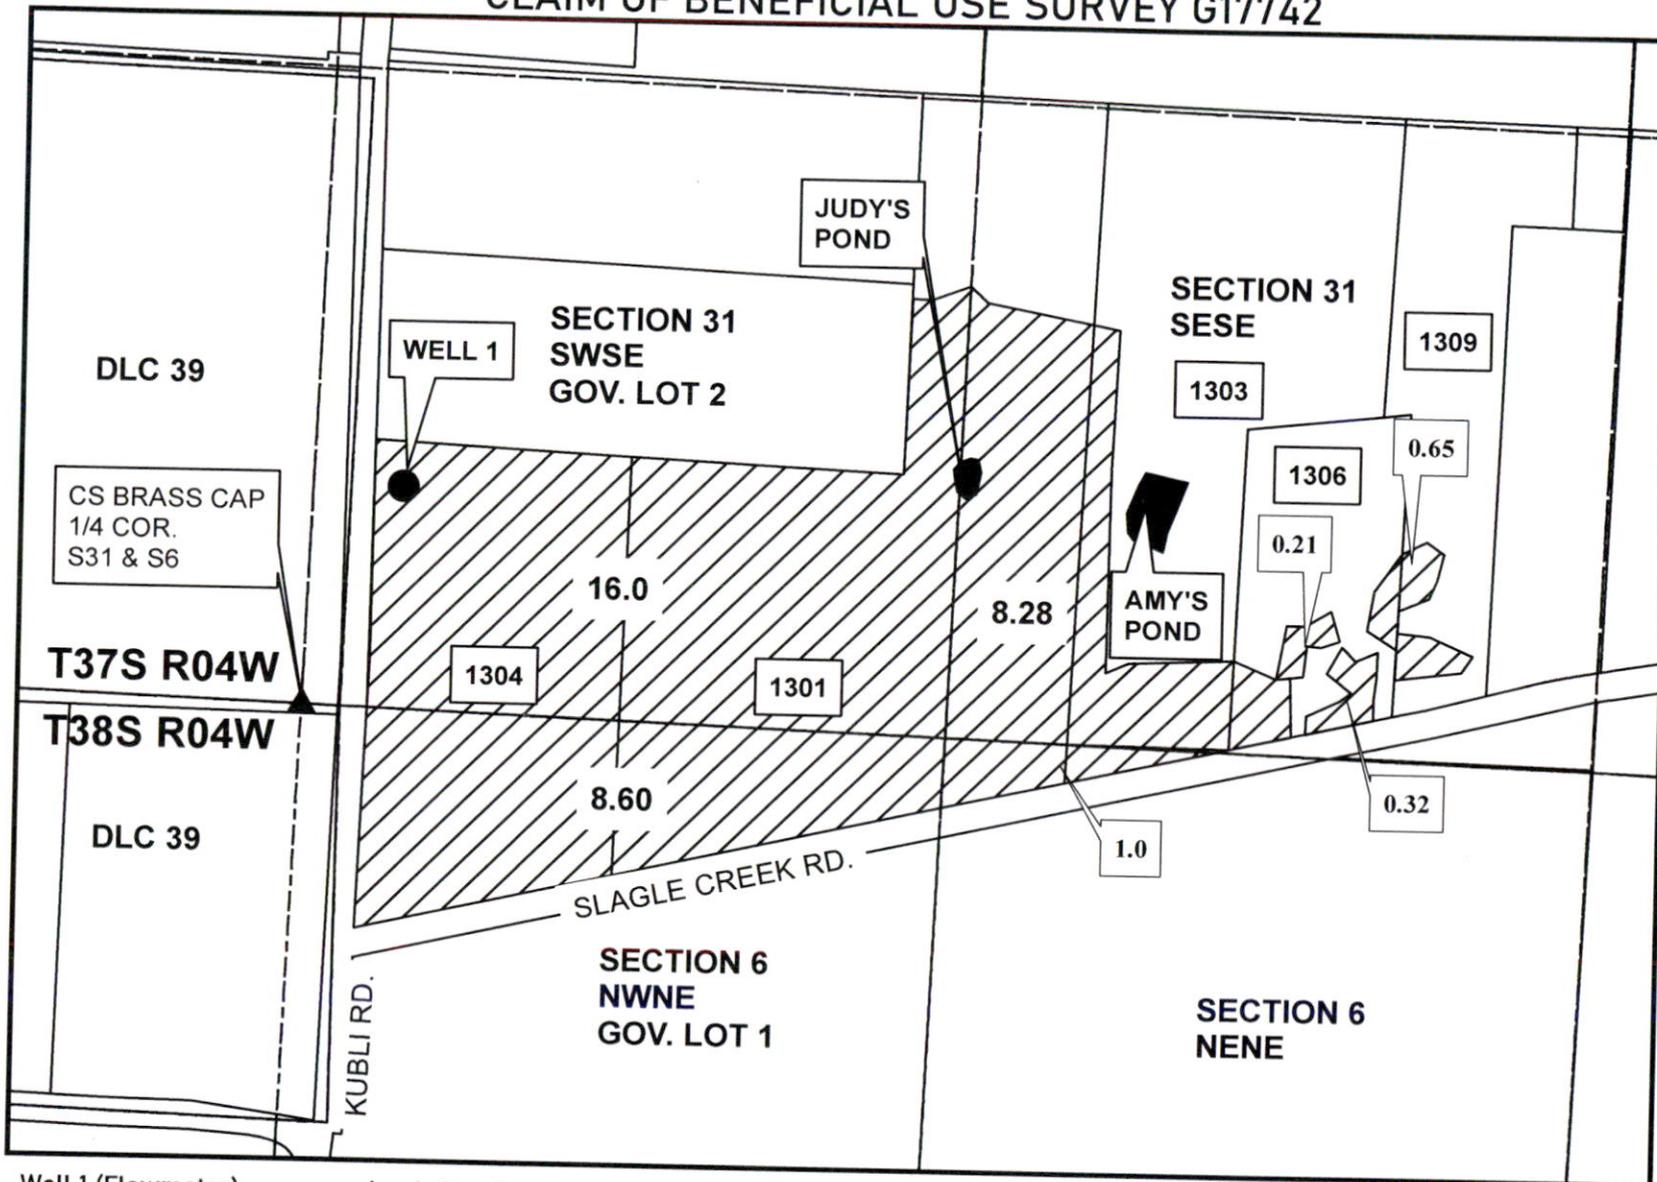

1 inch = 400 feet

FOR WATER RIGHTS PURPOSES ONLY.
NOT FOR PROPERTY BOUNDARY LOCATIONS OR DIMENSIONS.

PREPARED FOR:
Bruce Walport
Judy Walport
Eric Walport
Amy Walport
330 Slagle Creek Rd.
Grants Pass, OR 97527

PREPARED BY:
SCOTT FEIN WATER RIGHTS
600 Tyler Creek Rd.
Ashland, OR 97520
sfeinsurveyor@gmail.com
541-842-0795

Well 1 (Flowmeter)
From 1/4 Cor. S6 & S31
N 465FT., E 190 FT.

Amy's Pond
From 1/4 Cor. S6 & S31
N 525 FT., E 1720 FT.

Judy's Pond
From 1/4 Cor. S6 & S31
N 570FT., E 1350 FT.

LOCATION:
T37 R4W S31
T38S R4W S6
ROGUE RIVER BASIN
JACKSON COUNTY, OR

RECEIVED

SEP 09 2022

OWRD



EXPIRES: 12/31/20__